

MISSISSIPPI DEPARTMENT OF NATURAL RESOURCES

Bureau of Land and Water Resources

Southport Mall

P.O. Box 10631

Jackson, Mississippi 39209


WATER WELL DRILLERS LOG

Yazoo  
C 31

*Waded*


July 7 1988 *E.M. Dad* *CRESSWELL* *Yazoo*  
 date well completed firm name county well located

LANDOWNER: <i>no. 3</i>	description of formations encountered	from	to
<i>Harris Swayer</i> <i>Benton, Mo. 39039</i> (mailing address)	<i>Overburden</i>	<i>0</i>	<i>20</i>
WELL LOCATION:	<i>Upper Clay</i>	<i>20</i>	<i>30</i>
sec. <i>13</i> T. <i>12</i> N. R. <i>1</i> E.	<i>Hard sandstone</i>	<i>30</i>	<i>50</i>
2 miles <i>EAST</i> of <i>Midway</i>	<i>sand shale</i>	<i>50</i>	<i>160</i>
WELL PURPOSE: <i>farm</i> (home, irrigation, municipal, industrial)	<i>sand</i>	<i>160</i>	<i>180</i>
WELL COMPLETION DATA:	<i>shale</i>	<i>180</i>	<i>240</i>
(1) diameter (inches) <i>4</i>	<i>sand</i>	<i>240</i>	<i>250</i>
(2) total depth (feet) <i>400</i>	<i>shale</i>	<i>250</i>	<i>260</i>
(3) static water level (feet) <i>100</i> below top of ground.	<i>sand shale</i>	<i>260</i>	<i>400</i>
(4) casing <i>PVC 310</i> (material) (depth)			
<i>4</i> (size) if telescope see back.			
(5) screen <i>90 310</i> (length) (depth to top)			
<i>4</i> (size) <i>PVC</i> (material)			
(6) pump <i>5 70</i> (HP) (yield gpm)			
(type power)			
(7) electric log <i>no</i> (yes or no)			
(organization running log)			
(8) how well bottom plugged <i>Abil Shark</i>			
DRILLERS REMARKS:			

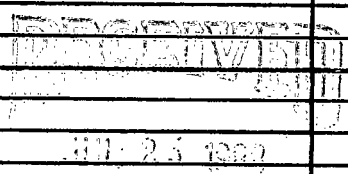

If well telescopes please sketch and show depths.

GROUND LEVEL

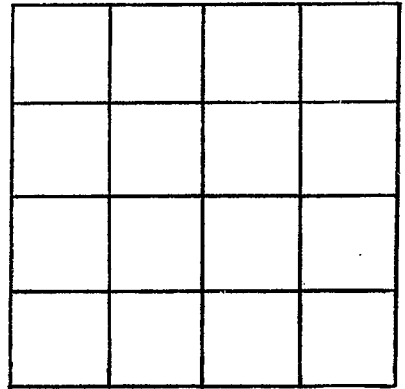

SECTION \_\_\_\_\_

Please indicate well location X.

ADDITIONAL INFORMATION

If more than one screen,  
show locations of each on sketch.