

MISSISSIPPI DEPARTMENT OF NATURAL RESOURCES

Bureau of Land and Water Resources

Southport Mall

P.O. Box 10631

Jackson, Mississippi 39209

WATER WELL DRILLERS LOG

Yazoo
C32

Coded

July 11 1988

E.H. Bud Gesswell

Yazoo

date well completed

firm name

county well located

LANDOWNER: No. 7
Harris Swayne
Benton, Mo. 63039
(mailing address)

description of formations encountered

from

to

Surface 0 15
Yazoo Clay 15 25
Tombigbee Branch 25 45
Shale - Blue and Phos 45 400
Sand - Blue shale 400 540


WELL LOCATION:
sec. 12 12 N R 1 E
2 miles EAST of Midway
(distance) (direction) (nearest town)

WELL PURPOSE: Farm
(home, irrigation, municipal, industrial)

WELL COMPLETION DATA:
(1) diameter (inches) 4
(2) total depth (feet) 540
(3) static water level (feet) 97 below top of ground.
(4) casing PVC 440 (material), (depth)
4 (size) if telescope see back.
(5) screen 100 440 (length), (depth to top)
4 PVC (size), (material)
(6) pump 5 70 (HP), (yield gpm)
(type power)
(7) electric log NO (yes or no)
(organization running log)

(8) how well bottom plugged
Sand Shale

DRILLERS REMARKS:

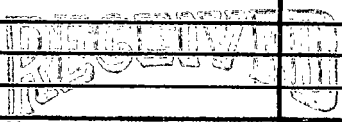


JUL 25 1988

MISSISSIPPI DEPARTMENT OF NATURAL RESOURCES
BUREAU OF LAND AND WATER RESOURCES

If well telescopes please sketch and show depths.

GROUND LEVEL

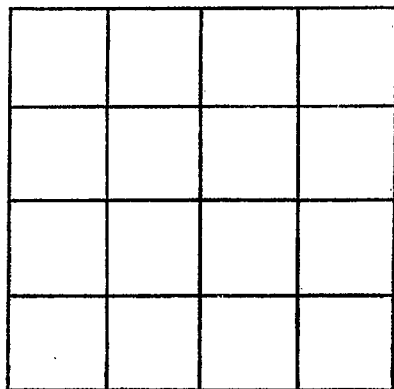

SECTION _____

Please indicate well location X.

ADDITIONAL INFORMATION

If more than one screen,
show locations of each on sketch.