

MISSISSIPPI DEPARTMENT OF NATURAL RESOURCES

Bureau of Land and Water Resources

Southport Mall

P.O. Box 10631

Jackson, Mississippi 39209

WATER WELL DRILLERS LOG

YA200
C33

Coded

July 14

1988 E.M. Bed *CRISWELL*


YA200

date well completed

firm name

county well located


LANDOWNER: <i>No. 5</i>	description of formations encountered	from	to
<i>Harris Swayne</i>	<i>Surface</i>	<i>0</i>	<i>15</i>
<i>Benton, Mo.</i>	<i>Green Clay</i>	<i>15</i>	<i>38</i>
(mailing address)	<i>Inducys Branch</i>	<i>38</i>	<i>62</i>
WELL LOCATION:	<i>Shale</i>	<i>62</i>	<i>200</i>
sec <i>13</i> T <i>12</i> N R <i>1</i> E	<i>sand</i>	<i>200</i>	<i>340</i>
<i>2</i> miles <i>EAST</i> of <i>Benton</i>			
(distance) (direction) (nearest town)			
WELL PURPOSE: <i>Farm</i>			
(home, irrigation, municipal, industrial)			
WELL COMPLETION DATA:			
(1) diameter (inches) <i>4</i>			
(2) total depth (feet) <i>340</i>			
(3) static water level (feet) <i>140</i> below top of ground.			
(4) casing <i>PVC</i> <i>250</i>			
(material) (depth)			
<i>4</i> (size) if telescope see back.			
(5) screen <i>90</i> <i>250</i>			
(length) (depth to top)			
<i>4</i> <i>PVC</i>			
(size) (material)			
(6) pump <i>5</i> <i>70</i>			
(HP) (yield gpm)			
(type power)			
(7) electric log <i>No</i>			
(yes or no)			
(organization running log)			
(8) how well bottom plugged			
<i>and back</i>			
DRILLERS REMARKS:			

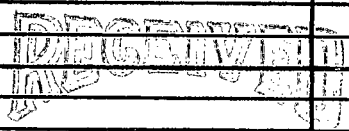

Department of Natural Resources
Bureau of Land and Water Resources

If well telescopes please sketch and show depths.

GROUND LEVEL

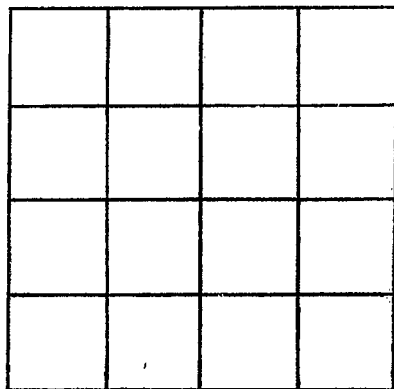

SECTION _____

Please indicate well location X.

ADDITIONAL INFORMATION

If more than one screen, show locations of each on sketch.