

MISSISSIPPI DEPARTMENT OF NATURAL RESOURCES

Bureau of Land and Water Resources

Southport Mall

P.O. Box 10631

Jackson, Mississippi 39209


WATER WELL DRILLERS LOG

Yazoo  
C 34  
7-18-88

Coded

July 18 1988 E.M. Bud Getwell Yazoo  
date well completed firm name county well located

LANDOWNER:	description of formations encountered	from	to
No. 6 Harris Wayze Benton, Mo. 39039 (mailing address)			
WELL LOCATION:			
sec. 23 T. 12 N. R. 1 E 2 miles EAST of Benton (distance) (direction) (nearest town)			
WELL PURPOSE: Farm (home, irrigation, municipal, industrial)			
WELL COMPLETION DATA:			
(1) diameter (inches) 4			
(2) total depth (feet) 350			
(3) static water level (feet) 120 below top of ground.			
(4) casing PVC 250 (material) (depth)			
4 (size) If telescope see back.			
(5) screen 100 250 (length) (depth to top)			
4 PVC (size) (material)			
(6) pump 5 70 (HP) (yield gpm)			
(type power)			
(7) electric log no (yes or no)			
(organization running log)			
(8) how well bottom plugged Sand shank			
DRILLERS REMARKS:			

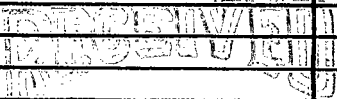


JUL 25 1988

Mississippi Department of Natural Resources  
Bureau of Land and Water Resources

If well telescopes please sketch and show depths.

GROUND LEVEL

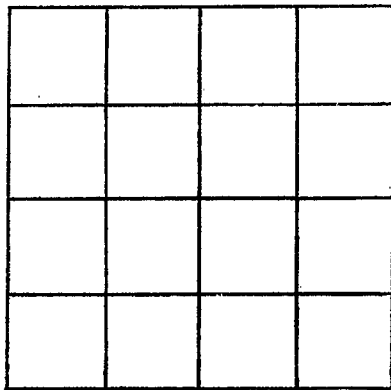

SECTION \_\_\_\_\_

Please indicate well location X.

ADDITIONAL INFORMATION

If more than one screen,  
show locations of each on sketch.