

MISSISSIPPI DEPARTMENT OF NATURAL RESOURCES

Bureau of Land and Water Resources

Southport Mall

P.O. Box 10631


Jackson, Mississippi 39209

WATER WELL DRILLERS LOG

2/12/00  
C 35  
CODED


Aug. 2 1998 E.M. Bad CRESSWELL Yazoo  
date well completed firm name county well located

| LANDOWNER:  | description of formations encountered | from | to  |
|---|---------------------------------------|------|-----|
| Harris Swayze<br>54th Fish Co.  | Oxford deposits                       | 0    | 25  |
| Benton, (mailing address) Mrs.  | Shale - gray                          | 25   | 210 |
| WELL LOCATION:  | Sandy shale                           | 210  | 300 |
| sec. 14 T 12 N R 1 E<br>2 miles East of Midway<br>(distance) (direction) (nearest town) | Sand - pits shale                     | 300  | 395 |
| WELL PURPOSE: Farm<br>(home, irrigation, municipal, industrial)                         |                                       |      |     |
| WELL COMPLETION DATA:   |                                       |      |     |
| (1) diameter (inches) 4   |                                       |      |     |
| (2) total depth (feet) 395  |                                       |      |     |
| (3) static water level (feet) 105 below top of ground.                                  |                                       |      |     |
| (4) casing PVC, 295 (material), (depth)<br>4 (size) if telescope see back.              |                                       |      |     |
| (5) screen 100, 295 (length), (depth to top)<br>4, PVC (size), (material)               |                                       |      |     |
| (6) pump 5, 75 (HP), (yield gpm)<br>(type power)  |                                       |      |     |
| (7) electric log no (yes or no)<br>(organization running log)                           |                                       |      |     |
| (8) how well bottom plugged<br>Sand shale   |                                       |      |     |
| DRILLERS REMARKS:   |                                       |      |     |

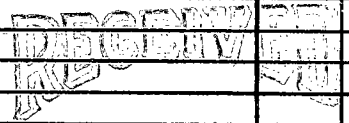

If well telescopes please sketch and show depths.

GROUND LEVEL

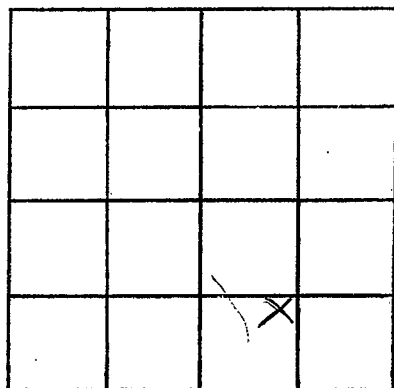

SECTION 14

Please indicate well location X.

ADDITIONAL INFORMATION

If more than one screen,  
show locations of each on sketch.