

MISSISSIPPI DEPARTMENT OF NATURAL RESOURCES

Bureau of Land and Water Resources

Southport Mall

P.O. Box 10631

Jackson, Mississippi 39209

WATER WELL DRILLERS LOG

Yazoo
C 36
CODED

Aug. 4 1988 S.E.M. Bud Russell Yazoo
date/well completed firm name county well located


LANDOWNER:	description of formations encountered	from	to
HARRIS Swayze Benton, MS. (mailing address)			
WELL LOCATION: sec. 23 T 12 N R 1 E 2 miles East of Midway (distance) (direction) (nearest town)			
WELL PURPOSE: <u>farm</u> (home, irrigation, municipal, industrial)			
WELL COMPLETION DATA:			
(1) diameter (inches) <u>4</u>			
(2) total depth (feet) <u>360</u>			
(3) static water level (feet) <u>120</u> below top of ground.			
(4) casing <u>PVC</u> , <u>260</u> , (material) (depth) <u>4</u> (size) if telescope see back.			
(5) screen <u>100</u> <u>260</u> (length) (depth to top) <u>4</u> <u>PVC</u> (size) (material)			
(6) pump <u>5</u> <u>75</u> (HP) (yield gpm) (type power)			
(7) electric log <u>No</u> (yes or no) (organization running log)			
(8) how well bottom plugged <u>Sand Shale</u>			
DRILLERS REMARKS:			

RECEIVED
AUG 31 1988

Department of Natural Resources
Bureau of Land & Water Resources

If well telescopes please sketch and show depths.

GROUND LEVEL

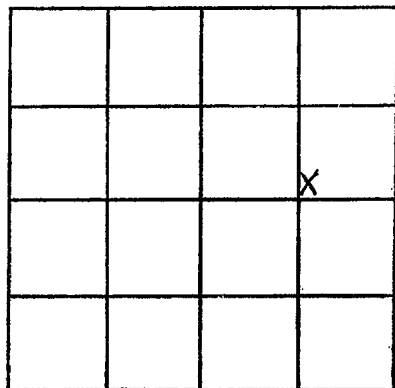

SECTION 23

Please indicate well location X.

ADDITIONAL INFORMATION

If more than one screen,
show locations of each on sketch.