

MISSISSIPPI DEPARTMENT OF NATURAL RESOURCES

Bureau of Land and Water Resources

Southport Mall

P.O. Box 10631

Jackson, Mississippi 39209

WATER WELL DRILLERS LOG

Y4200
C 37
CODED

Aug. 8 1988 E.M. Bad Gesswel Y4200
date well completed firm name county well located

LANDOWNER:	description of formations encountered	from	to
<u>Harris Swartz</u> <u>BENTON, MS.</u> (mailing address)			
WELL LOCATION: sec. <u>14</u> T. <u>12</u> N. R. <u>1</u> E <u>2</u> miles <u>EAST</u> of <u>Midway</u> (distance) (direction) (nearest town)			
WELL PURPOSE: <u>farm</u> (home, irrigation, municipal, industrial)			
WELL COMPLETION DATA:			
(1) diameter (inches) <u>4</u>			
(2) total depth (feet) <u>340</u>			
(3) static water level (feet) <u>140</u> below top of ground.			
(4) casing <u>PVC</u> <u>240</u> (material) (depth)			
<u>4</u> if telescope see back. (size)			
(5) screen <u>100</u> <u>240</u> (length) (depth to top)			
<u>4</u> <u>PVC</u> (size) (material)			
(6) pump <u>5</u> <u>75</u> (HP) (yield gpm)			
(type power)			
(7) electric log <u>-</u> (yes or no)			
(organization running log)			
(8) how well bottom plugged <u>Sand Shale</u>			


RECEIVED
AUG 31 1988

Department of Natural Resources
Bureau of Land & Water Resources

DRILLERS REMARKS:

If well telescopes please sketch and show depths.

GROUND LEVEL

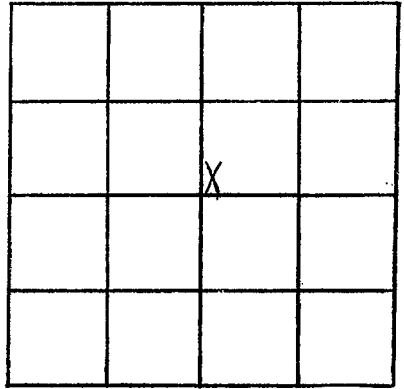

SECTION 14

Please indicate well location X.

ADDITIONAL INFORMATION

If more than one screen,
show locations of each on sketch.