

MISSISSIPPI DEPARTMENT OF NATURAL RESOURCES

Bureau of Land and Water Resources

Southport Mall

P.O. Box 10631


Jackson, Mississippi 39209

WATER WELL DRILLERS LOG

44200  
C38  
CODED

Aug. 10 1988 E.M. Bud KESSWELL 4A200  
date well completed firm name county well located


LANDOWNER:	description of formations encountered	from	to
Harry Swayze Benton, Mo. (mailing address)	Surficial deposit Yellow clay Midway Brack Brown shale Sandy shale, silt, sand sand	0 30 50 65 140 340	30 50 65 140 340 410
<b>WELL LOCATION:</b> sec. <u>14</u> T. <u>12</u> N. R. <u>1</u> E. <u>2</u> miles <u>EAST</u> of <u>Midway</u> (distance) (direction) (nearest town)			
<b>WELL PURPOSE:</b> <u>farm</u> (home, irrigation, municipal, industrial)			
<b>WELL COMPLETION DATA:</b> (1) diameter (inches) <u>4</u> (2) total depth (feet) <u>410</u> (3) static water level (feet) <u>120</u> below top of ground. (4) casing <u>PVC</u> <u>310</u> (material), (depth), <u>4</u> (size) If telescope see back. (5) screen <u>100</u> <u>310</u> (length), (depth to top), <u>4</u> (size), <u>PVC</u> (material) (6) pump <u>5</u> <u>75</u> (HP), (yield gpm) (type power) (7) electric log <u>no</u> (yes or no) (organization running log) (8) how well bottom plugged <u>partially</u>			
<b>DRILLERS REMARKS:</b>			

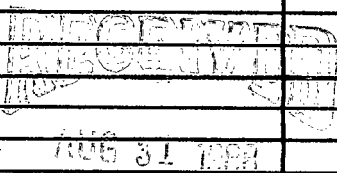

Department of Natural Resources  
Bureau of Land & Water Resources

If well telescopes please sketch and show depths.

GROUND LEVEL

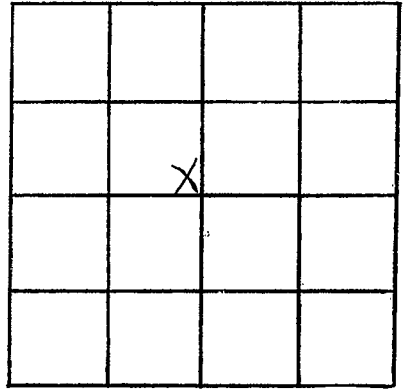

SECTION 14

Please indicate well location X.

ADDITIONAL INFORMATION

If more than one screen,  
show locations of each on sketch.