

MISSISSIPPI DEPARTMENT OF NATURAL RESOURCES

Bureau of Land and Water Resources

Southport Mall

P.O. Box 10631

Jackson, Mississippi 39209

WATER WELL DRILLERS LOG

Yazoo
C 39

CODED

Aug. 22 1988 E.M. Bud Cresswell Yazoo
date well completed firm name county well located

LANDOWNER: No. 11
HARRIS Swartz
BENTON, Ms. 39039
(mailing address)

description of formations encountered	from	to
Surface Mat.	0	25
Yellow Clay	25	40
Marly Sand	40	50
Green shale	50	160
Dark shale	160	220
Shale	220	290
Dark-stick shale	290	420

WELL LOCATION:
sec. 13 T 12 N R 1 E
2 miles EAST of Midway
(distance) (direction) (nearest town)

WELL PURPOSE: Farm
(home, irrigation, municipal, industrial)

- WELL COMPLETION DATA:
- (1) diameter (inches) 4
 - (2) total depth (feet) 420
 - (3) static water level (feet) 150 below top of ground.
 - (4) casing PVC 320 (material), (depth)
4 (size) if telescope see back.
 - (5) screen 100 320 (length), (depth to top)
4 PVC (size), (material)
 - (6) pump 5 70 (HP), (yield gpm)
(type power)
 - (7) electric log no (yes or no)
(organization running log)
 - (8) how well bottom plugged
Dark shale

RECEIVED


SEP 20 1988

Department of Natural Resources
Bureau of Land & Water Resources

DRILLERS REMARKS:

If well telescopes please sketch and show depths.

GROUND LEVEL

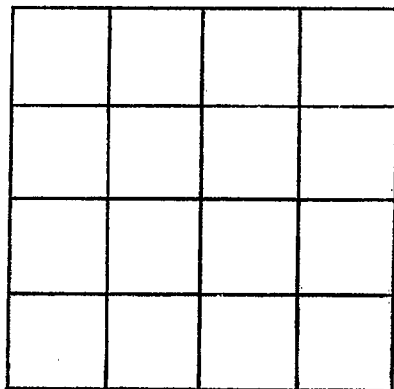

SECTION _____

Please indicate well location X.

ADDITIONAL INFORMATION

If more than one screen,
show locations of each on sketch.