

C. J. ...
9-25-62

WATER WELL DRILLERS LOG

SIA
Yazoo

Date: 9/25, 1962, Driller: Bailey Drlg. Co. (Name) County: Washington

(1) Owner of Land: Yazoo County
(Name)
Kings School
(Address)

(2) Location: SE 1/4, SE 1/4, Sec. 16 T. 12 N. R. 12 E
6 miles North of Benton
(distance) (direction) (Nearest Town)

(3) Topography: Hilly
(Hilly) (Flat) (Level)

(4) Purpose of Well: School
(Domestic, Irrigation, Municipal, Industrial, Other)

Description & Color of Materials Sand, Clay, Red Clay, Shell, etc.	Thick- ness Feet	Depth Feet
Clay	80	80
Sand + Mud		100
Mud		143
Sand + Mud		225
Sand		310
Mud		330
Sand		418
Mud		443
Sand		460
Mud + Sand		574
Rocks + Mud		825
Sand		930
Mud		974
Sand		1028
Mud		1170
Sand		1152
Rocks + Mud		1669
Fine Sand		1690
Sand + Mud		1710
Mud		1772
Sand + Mud		1792
Mud		1833
Sand		1900

Information upon completion of well:

(1) Diameter: 4 x 2 1/2 inches.

(2) Total Depth: 1900 feet.

(3) Water Level: 44 feet below top of ground.

(4) Cased to: all way Size: 4 x 2 1/2


(5) Screen: Size: 2 1/2 40, Length: 40.

(6) Were any formations sealed against pollution?
 yes, no.

If YES, depth of formation _____

Why _____

Drillers Remarks: _____

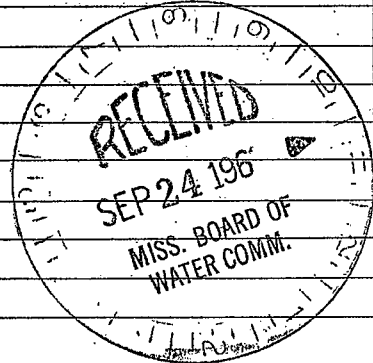

(Use Back Side)

Well No.

[The page contains extremely faint and illegible text, likely bleed-through from the reverse side of the document. No specific words or phrases can be identified.]