

MISSISSIPPI DEPARTMENT OF ENVIRONMENTAL QUALITY

Office of Land and Water Resources

P. O. Box 10631
Jackson, MS 39289-0631

WATER WELL DRILLERS LOG

COUNTY WELL LOCATED VAZOO	
WELL NUMBER C	CODED
DATE WELL COMPLETED FEB. 29, 1996	

PERMIT NUMBER
NAME OF DRILLING FIRM K.M. BOB CRESSWELL
BENTONIA, MS-39040

NAME & MAILING ADDRESS OF LANDOWNER Brooks Griffin		
354 Lyncrest Ave.		
JACKSON, MS. 39202		
WELL LOCATION: SEC	TOWNSHIP	RANGE
32	13 N	1 E
DISTANCE	DIRECTION	NEAREST TOWN
8 Miles	SE	EBEN
OTHER LANDMARK		
WELL PURPOSE: Home, Irrigation, Municipal, Industrial, Fish Pond, etc. CAMP		

PUMP DATA		
PUMP TYPE (Circle One): <input checked="" type="radio"/> Submersible Turbine, Jet Flowing Well, Other (Describe) _____		
POWER TYPE (Circle One): <input checked="" type="radio"/> Electric Tractor, Diesel, Gasoline, <input checked="" type="radio"/> Butane, Other (Describe) _____ H/P _____		
Pump Capacity (GPM) 12	No. of Stages 14	Setting Depth 105 FT.
PUMP TEST		
Well yielded 50 GPM with a drawdown of 10 ft. after 1/2 hours of pumping		

WELL DATA.		
Well Depth 220	Casing Diameter (In.) 4	Casing Length (Ft.) 200
Type of Casing PVC	Hole Depth 220	Depth to Static Water Level 62

LOG DATA	
TYPE OF LOG RUN (Circle One): Electric, Gamma Ray, Density, Sonic, Neutron, Other (Describe) None	
Name of Organization Running Log	

TYPE OF COMPLETION: (Circle One or More): <input checked="" type="checkbox"/> Gravel Packed, Underreamed, Telescoped, <input checked="" type="checkbox"/> Natural Development, Open Hole, Other	
WELL GROUTED TO A DEPTH OF 20 FEET Type-Grout (circle one): Cement, <input checked="" type="checkbox"/> Bentonite, or Mix	

GEOLOGIC DATA (Office Use Only)			
Surface Elev.	Geologic Unit	Unit Thickness	Depth to Top
Subs. SWL	Date	Analysis	Aquifer Test

SCREEN DATA		
Diameter - Inches 4	Length - Feet 20	Slot Size - Inches .010
Screen Type PVC	Depth to Bottom - Feet 220	


Driller's Remarks
REGISTERED
MAR 05 1996

DESCRIPTION OF FORMATIONS ENCOUNTERED	FROM	TO	FORMATIONS (Continued)	
			FROM	TO
SURFACE DEPOSIT	0	30	Dept. of Environmental Quality	
SAND	30	220	Office of Land & Water Resources	

IF MORE SPACE IS NEEDED, USE BACK

If well telescopes please
sketch and show depths.

GROUND LEVEL

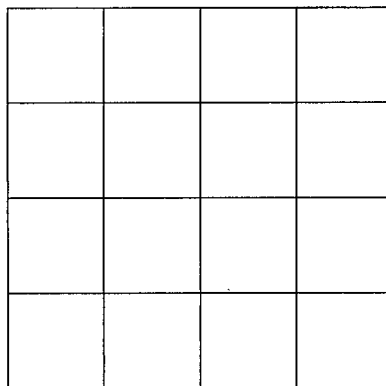

SECTION _____

Please indicate well location X.

ADDITIONAL INFORMATION

If more than one screen,
show location of each on sketch.