

MISSISSIPPI DEPARTMENT OF NATURAL RESOURCES

Bureau of Land and Water Resources

Southport Mall

P.O. Box 10631

Jackson, Mississippi 39209

CODED

WATER WELL DRILLERS LOG

*Griner Drilling Service, Inc.*

*Yazoo*

YA200  
D8  
10/31/81

10-31-81  
date well completed

firm name

county well located

| LANDOWNER:   | description of formations encountered | from       | to         |
|--|---------------------------------------|------------|------------|
|  |                                       |            |            |
| <i>Parco Drilling</i><br><i>P.O. Box 873</i><br><i>Natchez, MS 39120</i><br>(mailing address)          | <i>chalk</i>                          | <i>0</i>   | <i>105</i> |
|  | <i>sand</i>                           | <i>105</i> | <i>252</i> |
| WELL LOCATION: <i>9905 + 1650' W</i><br>sec. <i>21 T-12N</i> R- <i>2E</i> of <i>W. NE/4</i>            | <i>streaked chalk</i>                 | <i>252</i> | <i>378</i> |
| <i>No. 1</i><br><i>0.1 miles</i> <i>Midway</i><br><i>1-21</i> (distance) (direction) of (nearest town) |                                       |            |            |
| WELL PURPOSE: <i>oil field supply</i><br>(home, irrigation, municipal, industrial)                     |                                       |            |            |
| WELL COMPLETION DATA:  |                                       |            |            |
| (1) diameter (inches) <i>3"</i>  |                                       |            |            |
| (2) total depth (feet) <i>378'</i>   |                                       |            |            |
| (3) static water level (feet) <i>35'</i> <i>below</i> above top of ground.                             |                                       |            |            |
| (4) casing <i>steel</i> , <i>252'</i><br>(material) (depth)  |                                       |            |            |
| <i>3"</i><br>(size) if telescope see back.   |                                       |            |            |
| (5) screen <i>42'</i> , <i>210'</i><br>(length) (depth to top)   |                                       |            |            |
| <i>3"</i> , <i>perforated</i><br>(size) (material)   |                                       |            |            |
| (6) pump <i>—</i> , <i>75</i><br>(HP) (yield gpm)  |                                       |            |            |
| <i>AC</i><br>(type power)  |                                       |            |            |
| (7) electric log <i>—</i><br>(yes or no)   |                                       |            |            |
| <i>—</i><br>(organization running log)   |                                       |            |            |
| (8) how well bottom plugged <i>orange</i><br><i>peel</i>   |                                       |            |            |
| DRILLERS REMARKS:  |                                       |            |            |

CODED


DEPT. OF NATURAL RESOURCES  
BUREAU OF LAND & WATER RESOURCES

NOV 9 - 1981

RECEIVED

If well telescopes please sketch and show depths.

GROUND LEVEL

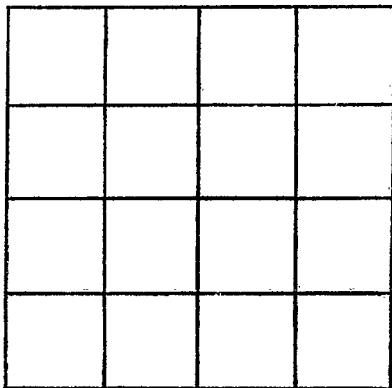

SECTION \_\_\_\_\_

Please indicate well location X.

ADDITIONAL INFORMATION

If more than one screen, show locations of each on sketch.