

MISSISSIPPI
BOARD OF WATER COMMISSIONERS
416 North State Street
Jackson, Mississippi 39201

WATER WELL DRILLERS LOG

Y200
D 14
113-081
Elec Log
3
date well completed

W. H. Butler
firm name


Y200
county well located

LANDOWNER: Southern Bell Tele. Co - Pickens Miss.
(mailing address)
WELL LOCATION: SW 1/4 NE 1/4 SW 1/4
sec. 21 T. 12 (N) R. 2 (E) S
8 miles West of Pickens
(distance) (direction) (nearest town)

description of formations encountered	from	to
Red Clay Red Sand	0	33
Gray Chalk - Gray Sand	33	64
Sand	64	219
Sand + Chalk	219	407
Rock	407	438
Sand + Chalk	438	532
Sand	532	594
Sand - Chalk	594	785
Shell - Chalk - Sand	785	815
Sand - Chalk	815	846
Rock + Chalk	846	878
Sand	878	939
Chalk	939	970
Chalk + Sand	970	1030
Hard Chalk + Rock	1030	1060
Shale	1060	1460
Sand + Shale	1460	1540
Rock	1540	1560
Sand -	1560	1750

WELL PURPOSE: Industrial
(home, irrigation, municipal, industrial)

WELL COMPLETION DATA:
(1) diameter (inches) 4 X 2 1/2
(2) total depth (feet) 1758
(3) static water level (feet) 80 (below/above top of ground)
(4) casing 92 1/4 / 1058
(material) (depth)
4" if telescope see back.
(size) 2 1/2" - 651'
(5) screen 50' / 1688'
(length) (depth to top)
2" / S.S.
(size) (material)
(6) pump 3 sub.
(HP) (yield gpm)
Electric
(type power)
(7) electric log yes
(yes or no)
U.S. Geol. Surv.
(organization running log)
(8) how well bottom plugged 2. B.W.V.

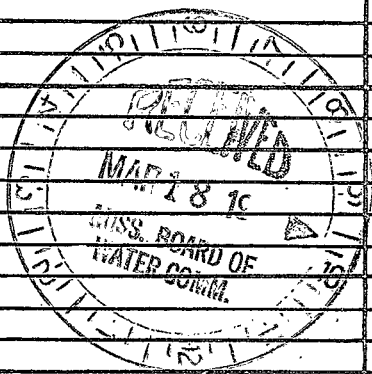


DRILLERS REMARKS:

over

If well telescopes please sketch and show depths.

GROUND LEVEL

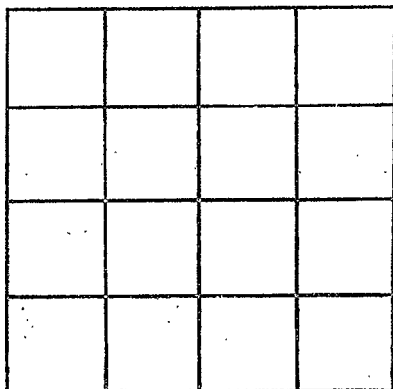

SECTION _____

Please indicate well location X.

ADDITIONAL INFORMATION

If more than one screen, show locations of each on sketch.