

Yazoo Co
 D 17
 4-3-70

MISSISSIPPI
 BOARD OF WATER COMMISSIONERS
 416 North State Street
 Jackson, Mississippi 39201

WATER WELL DRILLERS LOG

April 3 1970 to Sud Cresswell Yazoo
 date well completed firm name county well located

LANDOWNER:

R. B. Vaughn
 Vaughn, Miss.
 (mailing address)

description of formations encountered

from to

Clay	0	60
Shale	60	250
Sand	250	325

WELL LOCATION:

sec. 32 T. 12 N. R. 2 E 150
 6 miles East of Benton
 (distance) (direction) (nearest town)

WELL PURPOSE: Domestic
 (home, irrigation, municipal, industrial)

WELL COMPLETION DATA:

- (1) diameter (inches) 2
- (2) total depth (feet) 325
- (3) static water level (feet) 90 below top of ground.
- (4) casing galv. 305 (material) (depth)
 2 (size) if telescope see back.
- (5) screen 20 305 (length) (depth to top)
 2 stainless (size) (material)
- (6) pump (HP) (yield gpm)
 (type power)
- (7) electric log (yes or no)
 (organization running log)
- (8) how well bottom plugged


APR 24 1970

DRILLERS REMARKS:

MISS. Bd. of
 WATER COMMISSIONERS

If well telescopes please sketch and show depths.

GROUND LEVEL

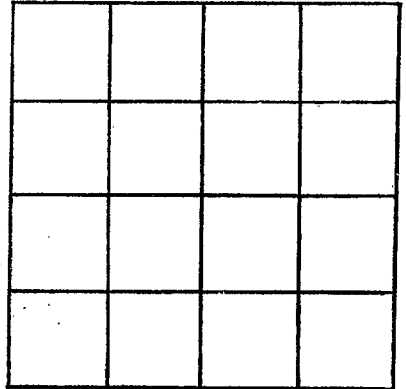

SECTION _____

Please indicate well location X.

ADDITIONAL INFORMATION

If more than one screen, show locations of each on sketch.