

Yazoo
 D18
 5-26-70

MISSISSIPPI
 BOARD OF WATER COMMISSIONERS
 416 North State Street
 Jackson, Mississippi 39201

CODED

WATER WELL DRILLERS LOG

5-26-1970 date well completed F.M. "Bud" Cresswell firm name Yazoo county well located

LANDOWNER:
 Henrietta CARTER
 Vaughn, Miss-
 (mailing address)

description of formations encountered	from	to
Clay	0	30
3A wd	30	47

WELL LOCATION:
 sec. 4 T. 12 N. R. 3 E.
 2 miles West of Vaughn
 (distance) (direction) (nearest town)

WELL PURPOSE: Domestic
 (home, irrigation, municipal, industrial)

WELL COMPLETION DATA:

(1) diameter (inches) 2

(2) total depth (feet) 47

(3) static water level (feet) 30 below top of ground.

(4) casing Steel 42 (material), (depth)
 2 (size) if telescope see back.

(5) screen 5 42 (length), (depth to top)
 2 Stainless (size), (material)

(6) pump 3/4 5 gpm (HP), (yield gpm)
 0 (type power)

(7) electric log No (yes or no)
 0 (organization running log)

CODED

(8) how well bottom plugged
 Steel plug


DRILLERS REMARKS:

JUN 23 1970

MISS. BD. OF
 WATER COMM.

If well telescopes please sketch and show depths.

GROUND LEVEL

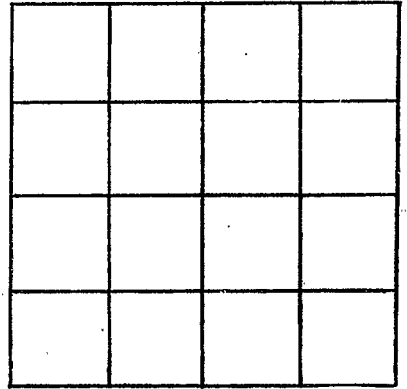

SECTION _____

Please indicate well location X.

ADDITIONAL INFORMATION

If more than one screen,
show locations of each on sketch.