

MISSISSIPPI DEPARTMENT OF NATURAL RESOURCES

Bureau of Land and Water Resources

Southport Mall

P.O. Box 10631

CODED

Jackson, Mississippi 39209

WATER WELL DRILLERS LOG

Aug. 4 1982 *B. E. M. "Bud" Cresswell* Yazoo
 date well completed firm name county well located

LANDOWNER:
Bethlan Production Co.
Monroe, La.
 (mailing address)

description of formations encountered	from	to
<i>Shale</i>	<i>0</i>	<i>60</i>
<i>Sand and shale</i>	<i>60</i>	<i>150</i>

WELL LOCATION:
 sec. *10* T. *12* N. R. *2* E
4 miles *East* of *Fickens*
 (distance) (direction) (nearest town)

WELL PURPOSE: *Industrial*
 (home, irrigation, municipal, industrial)

CODED

- WELL COMPLETION DATA:
- (1) diameter (inches) *3*
 - (2) total depth (feet) *150*
 - (3) static water level (feet) *60* below top of ground. *above*
 - (4) casing *Steel*, *130*
 (material) (depth)
 - 3*
 (size) if telescope see back.
 - (5) screen *20*, *130*
 (length) (depth to top)
 - 3*, *5*
 (size) (material)
 - (6) pump *air Comp.*
 (HP) (yield gpm)
 - (type power) *No.*
 - (7) electric log *No.*
 (yes or no)
 - (organization running log)
 - (8) how well bottom plugged *back wash valve*

DEPT. OF NATURAL RESOURCES
 BUREAU OF LAND & WATER RESOURCES


AUG 31 1982

RECEIVED

DRILLERS REMARKS:

If well telescopes please
sketch and show depths.

GROUND LEVEL

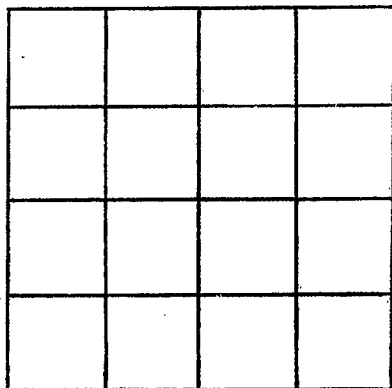

SECTION _____

Please indicate well location X.

ADDITIONAL INFORMATION

If more than one screen,
show locations of each on sketch.