

MISSISSIPPI DEPARTMENT OF NATURAL RESOURCES

Bureau of Land and Water Resources

Southport Mall

P.O. Box 10631

Jackson, Mississippi 39209

WATER WELL DRILLERS LOG

CODED

YAZOO
D 21
8-14-82

Aug. 14 1982 E.M. "Bud" CRESSWELL Yazoo
date well completed firm name county well located

LANDOWNER:
Bethlan Production Co.
Monroe, La.
(mailing address)

description of formations encountered	from	to
	Shale	0
Shale, silts and fine sand	80	410
	480	500

WELL LOCATION:
sec. 13 T 12 N R 2 E
4 miles East of Ficklen
(distance) (direction) (nearest town)

WELL PURPOSE: Industrial
(home, irrigation, municipal, industrial)

CODED

WELL COMPLETION DATA:

(1) diameter (inches) 3

(2) total depth (feet) 500

(3) static water level (feet) 110 below top of ground.

(4) casing Steel 480
(material) (depth)
3 if telescope see back.
(size)

(5) screen 20 480
(length) (depth to top)
3 Sparden
(size) (material)

(6) pump Air Comp
(HP) (yield gpm)
(type power) no

(7) electric log (yes or no)

(organization running log)

DEPT. OF NATURAL RESOURCES
BUREAU OF LAND & WATER RESOURCES

AUG 31 1982


RECEIVED

(8) how well bottom plugged
dash wash valve

DRILLERS REMARKS:

If well telescopes please
sketch and show depths.

GROUND LEVEL

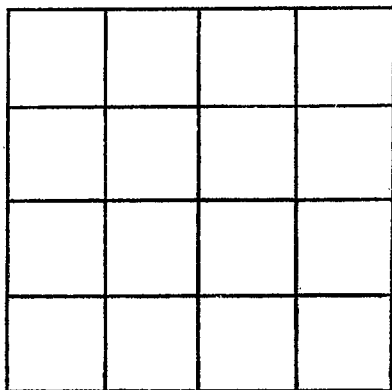

SECTION _____

Please indicate well location X.

ADDITIONAL INFORMATION

If more than one screen,
show locations of each on sketch.