

MISSISSIPPI DEPARTMENT OF NATURAL RESOURCES

Bureau of Land and Water Resources

COUNTY WELL LOCATED Vazoo	
WELL NUMBER No. 1	CODED D24
DATE WELL COMPLETED 12-28-88	

189 D

PERMIT NUMBER	NAME OF DRILLING FIRM Griner Drilling Service, Inc.
---------------	---

CODED

P.O. Box 10631
Jackson, Mississippi 39209
WATER WELL DRILLERS LOG

NAME & MAILING ADDRESS OF LANDOWNER David New Drilling		
P.O. Box 1487		
Natchez, Ms. 39120		
WELL LOCATION: SEC	TOWNSHIP	RANGE
30	12	3
DISTANCE	DIRECTION	NEAREST TOWN
	Pickens Field	
OTHER LAND MARK 330' N + 330' E OF SE COR.		
WELL PURPOSE: Home, Irrigation, Municipal, Industrial, Fish Pond, etc. Oilfield Rig Supply		

PUMP DATA		
PUMP TYPE (Circle One): Submersible, Turbine, Jet, Flowing Well, Other (Describe) No Pump		
POWER TYPE (Circle One): Electric, Tractor, Diesel, Gasoline, Butane, Other (Describe) Air Water Well		
Pump Capacity (GPM)	No. of Stages	Setting Depth
		FT.
PUMP TEST		
Well yielded 80 GPM with		
a drawdown of N/A ft.		
after 4 hours of pumping blowing		

WELL DATA		
Well Depth 609'	Casing Diameter (In.) 3"	Casing Length (Ft.) 570'
Type of Casing PVC	Hole Depth 609'	Depth to Static Water Level 100'
TYPE OF COMPLETION: (Circle One or More): Gravel Packed, Underreamed, Telescoped, Natural Development, Open Hole, Other (Describe)		
Top of Lap Pipe or Reduction in Casing		
FEET	IF TELESCOPED OR MORE THAN ONE SCREEN: USE BACK PAGE	

LOG DATA	
TYPE OF LOG RUN (Circle One): No Log Run, Electric, Gamma Ray, Density, Sonic, Neutron, Other (Describe)	
Name of Organization Running Log	

SCREEN DATA		
Diameter - Inches 3"	Length - Feet 40'	Slot Size - Inches .010
Screen Type PVC	Depth to Bottom - Feet 530'-570'	


GEOLOGIC DATA (Office Use Only)			
Surface Elev.	Geologic Unit	Unit Thickness	Depth to Top
Subs. SWL	Date	Analysis	Aquifer Test
Driller's Remarks			

DESCRIPTION OF FORMATIONS ENCOUNTERED	FROM	TO	FORMATIONS (Continued)	FROM	TO
Streaked clay + sand	0	105	RECEIVED JAN 27 1989 Department of Natural Resources Bureau of Land & Water Resources		
clay	105	336			
streaked	336	549			
sand	549	609			

IF MORE SPACE IS NEEDED, USE BACK

If well telescopes please
sketch and show depths.

GROUND LEVEL

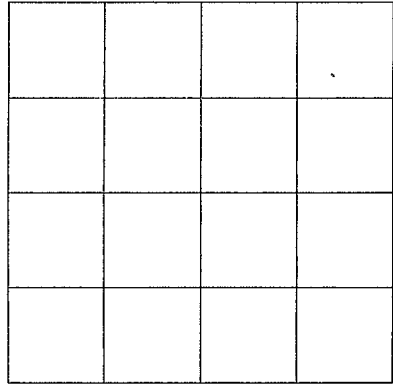

SECTION _____

Please indicate well location X.

ADDITIONAL INFORMATION

If more than one screen,
show location of each on sketch.