

MISSISSIPPI DEPARTMENT OF NATURAL RESOURCES

Bureau of Land and Water Resources

Southport Mall

P.O. Box 10631

Jackson, Mississippi 39209

WATER WELL DRILLERS LOG

Griner Drilling Service, Inc.

Yazoo

Yazoo
D26


187B  
Coded

7-22-90 date well completed

Griner Drilling Service, Inc. firm name

Yazoo county well located

LANDOWNER:	description of formations encountered	from	to
Par Co Drilling Co. P.O. Box 873 Natchez, Ms 39120 <small>(mailing address)</small>			
WELL LOCATION: 990' S + 330' W sec. 24 T. 12 N R. 2 E of No. 1 Beville Pickens Beville, miles (distance) (direction) (nearest town)	sand	84	126
WELL PURPOSE: oilfield rig <small>(home, irrigation, municipal, industrial)</small>	breaks	126	252
WELL COMPLETION DATA:	sand, shale	252	357
(1) diameter (inches) 3"	clay, lime rocks	357	600
(2) total depth (feet) 600'			
(3) static water level (feet) 65' below top of ground.			
(4) casing PVC 280' <small>(material) (depth)</small> 3" <small>(size) if telescope see back.</small>			
(5) screen No Screen <small>(length) (depth to top)</small> Open ended well <small>(size) (material)</small>			
(6) pump Air Compressor <small>(HP) (yield gpm) (type power)</small>			
(7) electric log <input checked="" type="checkbox"/> (yes or no) <small>(organization running log)</small>			
(8) how well bottom plugged open ended			
DRILLERS REMARKS:			

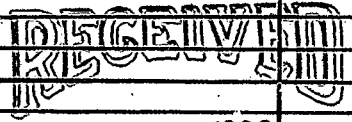


OCT 31 1990

Department of Natural Resources  
Bureau of Land & Water Resources

If well telescopes please sketch and show depths.

GROUND LEVEL

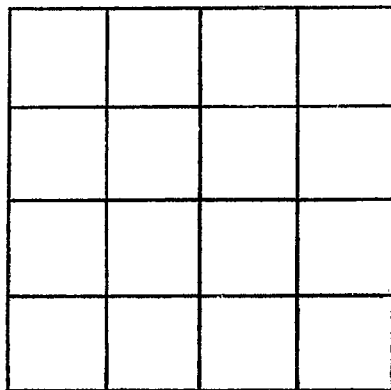

SECTION \_\_\_\_\_

Please indicate well location X.

ADDITIONAL INFORMATION

If more than one screen,  
show locations of each on sketch.