		ell Report	For Office Use Only:
County: Vazoo		art 1	
1 1	Mississippi Department	of Environmental Quality	Aquifer: Well #: D-30
Permit #:		nd Water Resources	Well #: <u>D-30</u>
Driller: Gary Rayborn		ox 10631	
		S 39289-0631	L. S. Elevation:
Date drilling completed: 4-15-08		961-5210 6938 (fax)	E-log #:
State Law requires that this report 30 days of completion of drilling of	rt be prepared by the	driller in detail and filed v	vith the Department within
Well Owner Informati	ion	We	ll Location
Owner Name_Liberty Re		Latitude:°'	_" Longitude:''
Mailing Address: 1090 Cin		Method of Lat/Long (circle o	
·		USGS quad; Hand-hel	d GPS, Survey-grade GPS
Port Allen, L	A 70767		
City State	-	Distance Direction	Nearest Town
Telephone No. (225 343 - 3	900	Miles	_ of
	Well		<u> </u>
	t I Dublic Sumly	Irrigation Fish Culture	Other: Ria Supply
Purpose of Well (circle one) Home Indu	istriai Public Supply	Ingation Fish Culture	15-2008
Date well drilling started: <u>4 - 14 - C</u>			
If flowing, method of flow regulation: Value	ve Other (o	lescribe)	4-15-2008
Static Water Level: <u>65</u> feet ab	ove or below (circle one)		
Method of Measurement (circle one) sto	eel tape electric tape		
Hole depth: 240 Well dep	oth: 240	_ Well grouted to a depth of	feet
Type of grout (circle one): Cement	Bentonite Mix		()
Casing length: 220 feet Casin	/ 1	inches Type of casing:	_PVC
	en diameter:	inches Type of screen:	PVC
Screen slot size: <u>1020</u> inches	Setting denth: From	ZZO feet to Z	40 feet
Type of completion (circle all applicable)(-	
Top of lap pipe or reduction in casing:			
Logs run (circle all applicable): No log ru	n Electric Gamma Ra	y Density Sonic Neutron	Other:
Name of organization running log(s): I certify that the well was drilled, constr	ructed, and completed in	accordance with all applicab	le requirements of the Mississippi
Department of Environmental Quality a	und/or the Mississippi De	partment of Health regulation	ons and state laws.
	1 GA.	_	
RAYBORN DRILLING, INC.	0-60		<u>z-y-</u>
Print Name of Water Well Contractor and	License No.	Signature	e of Water Well Contractor
L			DEACH
· · · ·			RECEIV
			MAY 1 3 20

BY: OLWR

If well telescopes please sketch below and show depths.



سو	Description of Formations Encountered	From	To
	Chack.	0	40
-	Fine Sand	40	35
	Chalk.	55	160
	Chalk_ Medium Sand	160	340
ŀ			
-			
ŀ			
r			
-			<u> </u>


D-30

RECEIVED

MAY 1 3 2008

BY: OLWR

If more than one screen, show location of each on sketch

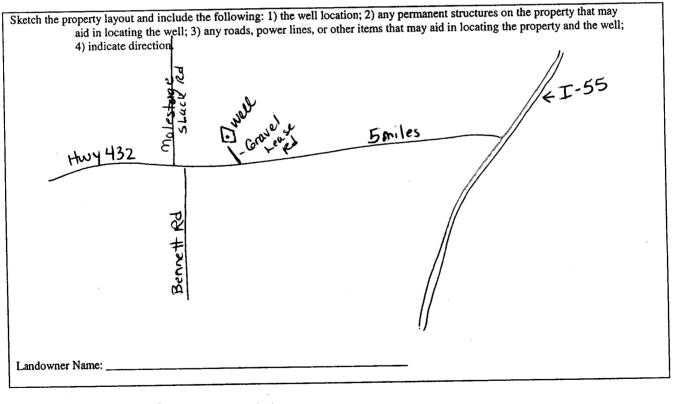

 \hat{a}_{i}

Signature of Water Well Contractor

County: <u>42200</u> Permit #: Driller: <u>Gary Rayborn</u> Date completed: <u>4-15-08</u>	Part Provide the second	CLL REPORT art 2 s Completion Report it of Environmental Quality and Water Resources 30x 10631 1S 39289-0631 961-5210 4-6938 (fax)	For Office Use (Aquifer: Well #:	30
This report should be prepared by th installation of pump. Well Owner Informat			ent within 30 days of the ell Location	
Owner Name: <u>Liberty Re</u> Mailing Address: <u>1090 Cincl</u> <u>Part Allen, L</u> City State	Latitude: Longitude: Method of Lat/Long (circle one): Conventional Survey, USGS quad, Hand-held GPS, Survey-grade GPS 14 14 SecZ1TwnI2N_RngZE Distance Direction Nearest Town			
Telephone No. (225) 343 - 391	0	Miles		<u>_</u>
Pump Type Circle one Air Lift Jet Bucket Piston Centrifugal Rotary Other (specify):	Submersible Turbine Flowing Well Gallons Per Minute	Diesel Engine Gaso Electric Motor Hand Windmill Othe Horse Power Rating of Moto Setting Depth:	1 Tra r (specify): or:5HP	
Pump Test Data Date Well Tested: $4 - 15 - 0.0$ Static Water Level (A): 65 Fee Pumping Water Level (B): Feet Drawdown [(B) - (A)]: Feet Test Pumping Rate: 60 Duration of Pump Test (minimum 4 hours)	t Below Land Surface Below Land Surface t Below Land Surface _Gallons Per Minute		shut in head: GPM with a drawdo	own of
I HEREBY CERTIFY that the above state <u>Gary Ray born</u> Print Name of Pump Installer and License	0-60	of my knowledge.	Installer	

, **x**

•

MAY 1 3 2008 BY: OLWR