

6-23-66

WATER WELL DRILLERS LOG

Date: 6/23, 1966, Driller: McKay County Zayad
 (Name)


(1) Owner of Land: Walter Deason
 (Name)
Vaughn
 (Address)
 (2) Location: NE 1/4, NE 1/4, Sec. 35 T¹² R^{2E}
4 miles W of Vaughn
 (distance) (direction) (Nearest Town)
 (3) Topography: (Hilly) (Flat) (Level)
 (4) Purpose of Well: Home
 (Domestic Irrigation
 Municipal, Industrial, Other)

Description & Color of Materials Sand, Clay, Red Clay, Shell, etc.	Thick- ness Feet	Depth Feet
<u>Red clay</u>	<u>0</u>	<u>20</u>
<u>White clay</u>	<u>20</u>	<u>70</u>
<u>White clay</u>	<u>40</u>	<u>120</u>
<u>Shale</u>	<u>60</u>	<u>180</u>
<u>Sand</u>	<u>80</u>	<u>100</u>
<u>Sand</u>	<u>100</u>	<u>120</u>
<u>Blue clay</u>	<u>120</u>	<u>220</u>
<u>Sandy clay</u>	<u>220</u>	<u>240</u>
<u>Blue clay</u>	<u>240</u>	<u>300</u>
<u>Fine sand</u>	<u>300</u>	<u>340</u>
<u>Shale - Rock str</u>	<u>340</u>	<u>400</u>
<u>Med Sand</u>	<u>400</u>	<u>420</u>
<u>Med Sand</u>	<u>420</u>	<u>440</u>

Information upon completion of well:

(1) Diameter 2 inches.
 (2) Total Depth 440 feet.
 (3) Water Level 63 feet below top of ground.
 (4) Cased to _____, Size _____
 (5) Screen: Size 007, Length 20
 (6) Were any formations sealed against pollution?
 _____ yes, no.

air unit

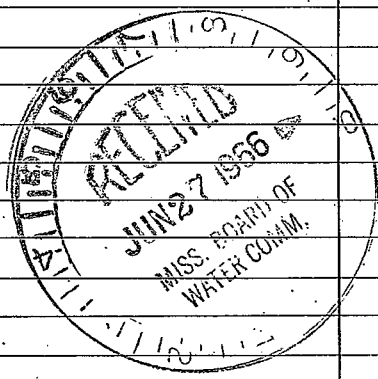

If YES depth of formation _____
 Why _____
 Drillers Remarks: _____

Well No.

(Use Back Side)

