


YAZOO
E6
6-5-72

82 MISSISSIPPI
BOARD OF WATER COMMISSIONERS
416 North State Street
Jackson, Mississippi 39201

WATER WELL DRILLERS LOG


YAZOO

6/5/72 1972 Geopost Drilling ~~State~~
date well completed firm name county well located

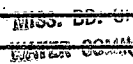LANDOWNER: <u>HARRIS and Seward</u>	description of formations encountered	from	to
<u>HARRIS AND SEWARD</u>	<u>clay</u>	<u>0</u>	<u>80</u>
<u>MIDNIGHT MISS.</u> (mailing address)	<u>sand</u> <u>pea gravel</u>	<u>50</u>	<u>80</u> <u>105</u>
WELL LOCATION: <u>Green Hill Plantation</u> sec. <u>12</u> T <u>N</u> R <u>4</u> E <u>1 1/2</u> miles <u>south</u> of <u>Louis</u> (distance) (direction) (nearest town)			
WELL PURPOSE: <u>Cattle water</u> (home, irrigation, municipal, industrial)			
WELL COMPLETION DATA:			
(1) diameter (inches) <u>9"</u>			
(2) total depth (feet) <u>105</u>			
(3) static water level (feet) <u>19.8</u> below top of ground.			
(4) casing <u>2.39 in</u> <u>99</u> (material) (depth)			
<u>2"</u> (size) if telescope see back.			
(5) screen <u>5'</u> <u>99</u> (length) (depth to top)			
<u>2"</u> <u>all stainless steel</u> (size) (material)			
(6) pump <u>1</u> <u>15</u> (HP) (yield gpm)			
<u>AC</u> (type power)			
(7) electric log <u>no</u> (yes or no)			
(organization running log)			
(8) how well bottom plugged <u>steel plug</u>			
DRILLERS REMARKS: <div style="text-align: right;">  MISS. DD. 01 JUN 10 1972 </div>			

If well telescopes please sketch and show depths.

GROUND LEVEL

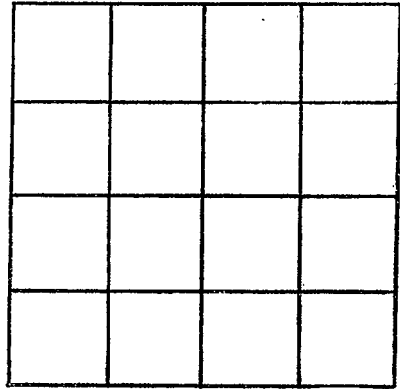

SECTION _____

Please indicate well location X.

ADDITIONAL INFORMATION

Lined area for additional information.

If more than one screen, show locations of each on sketch.