

MISSISSIPPI  
 BOARD OF WATER COMMISSIONERS  
 416 North State Street  
 Jackson, Mississippi 39201

**CODED**

**WATER WELL DRILLERS LOG**

Yazoo  
 E 20  
 4-25-70

April 25 1970 Date well completed  
 Buf Creswell firm name  
 Yazoo county well located

**LANDOWNER:**

R. B. Twist  
 Twist, Arkansas  
 (mailing address)

**description of formations encountered**

from to

sumbs 0 18  
 sand 18 35  
 sand-gravel 35 73

**WELL LOCATION:**

sec. 4 T. 12 N R. 4 E  
 10 miles South of Louise  
 (distance) (direction) (nearest town)

**WELL PURPOSE:** Farm  
 (home, irrigation, municipal, industrial)

**WELL COMPLETION DATA:**

- (1) diameter (inches) 4
- (2) total depth (feet) 73
- (3) static water level (feet) 15 below above top of ground.
- (4) casing galv. 63  
 (material) (depth)  
 40 (size) if telescope see back.
- (5) screen 10 63  
 (length) (depth to top)  
 4 (size) Stainless (material)
- (6) pump No pump installed  
 (HP) (yield gpm)
- (7) electric log \_\_\_\_\_  
 (yes or no)
- (organization running log) \_\_\_\_\_
- (8) how well bottom plugged \_\_\_\_\_

**CODED**


DATE  
 APR 21 1970

MISS. Bd. of  
 WATER COMMISSIONERS

**DRILLERS REMARKS:**

If well telescopes please  
sketch and show depths.

GROUND LEVEL

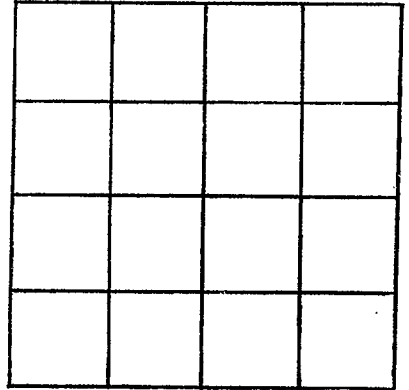

SECTION \_\_\_\_\_

Please indicate well location X.

ADDITIONAL INFORMATION

If more than one screen,  
show locations of each on sketch.