

VAZOO  
E21  
6-23-80

MISSISSIPPI  
BOARD OF WATER COMMISSIONERS  
416 North State Street  
Jackson, Mississippi 39201  
WATER WELL DRILLERS LOG

CODED

June 23 1980 Drilling & Associates  
date well completed firm name

Yazoo  
county well located

LANDOWNER: Woodard Farms #3

Tommy Woodard

Holly Bluff Ms

(mailing address)

WELL LOCATION:

sec. 21 T. 12 N. R. 5 E. S. W.  
5 miles N of Holly Bluff  
(distance) (direction) (nearest town)

WELL PURPOSE: Irrigation  
(home, irrigation, municipal, industrial)

WELL COMPLETION DATA:

- (1) diameter (inches) 16"  
(2) total depth (feet) 142'  
(3) static water level (feet) 15' (below above top of ground.)  
(4) casing Steel, 92' (material) (depth)  
if telescope see back.  
(5) screen 50', 92' (length) (depth to top)  
16", Steel (size) (material)  
(6) pump 6.5 3800 (HP) (yield gpm)  
Diesel (type power)  
(7) electric log no (yes or no)  
none (organization running log)  
(8) how well bottom plugged Steel Plug

description of formations encountered

from to

Clay	0	5
Clay	5	10
Clay	10	15
Clay	15	20
Clay	20	25
Clay	25	30
Clay	30	35
Clay Sand Shell	35	40
Clay Sand	40	45
Clay Sand	45	50
Clay Sand	50	55
Clay Sand	55	60
Clay Sand	60	65
Sand Clay	65	70
Sand Clay	70	75
Sand	75	80
Sand Clay	80	85
Sand Lignite	85	90
Sand Gravel	90	95
Gravel Sand	95	100
Gravel	100	105
Wood	105	110
Wood	110	115
Rock Gravel	115	120
Wood	120	125
Rock Gravel	125	130
Rock Gravel	130	135
Wood	135	136
Gravel	136	137
Wood	137	138
Gravel	138	142
Sandstone	142	


DRILLERS REMARKS:

MISSISSIPPI DEPT. OF NATURAL RESOURCES  
BUREAU OF LAND & WATER RESOURCES  
AUG 15 1980  
RECEIVED

①

If well telescopes please sketch and show depths.

GROUND LEVEL

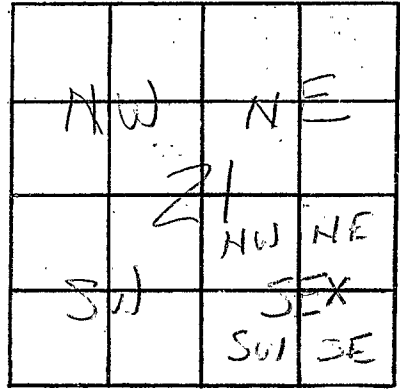

SECTION 21

Please indicate well location X.

ADDITIONAL INFORMATION

If more than one screen, show locations of each on sketch.