

MISSISSIPPI DEPARTMENT OF NATURAL RESOURCES

Bureau of Land and Water Resources

Southport Mall

P.O. Box 10631

Jackson, Mississippi 39209

WATER WELL DRILLERS LOG

Yazoo
E 22
3-25-81

March 25 1981
date well completed

Larry's well & pump
firm name

Yazoo
county well located

LANDOWNER: William Davis

description of formations encountered

CODED

from to

Holly Bluff
(mailing address)

CLAY	0	40
FINE MED SAND	40	63
COURSE SAND	65	116

WELL LOCATION:

sec. 12 T 12 N R 5
7 miles (distance) N (direction) of Holly Bluff (nearest town)

WELL PURPOSE:

(home, irrigation, municipal, industrial)

WELL COMPLETION DATA:

- (1) diameter (inches) 16"
- (2) total depth (feet) 116'
- (3) static water level (feet) 18' below above top of ground.
- (4) casing Steel (material), 76' (depth)

CODED

(size) If telescope see back.


- (5) screen 40' (length), 76' (depth to top)
16" (size), Steel (material)
- (6) pump 600 (HP), 3000 (yield gpm)

(type power)

- (7) electric log No (yes or no)

(organization running log)

- (8) how well bottom plugged Steel Plate

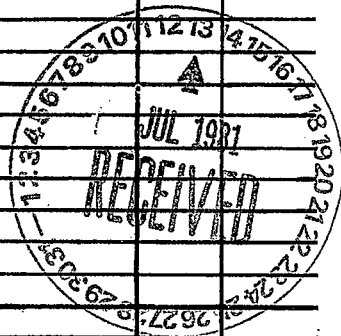


DRILLERS REMARKS:

(2)

If well telescopes please sketch and show depths.

GROUND LEVEL

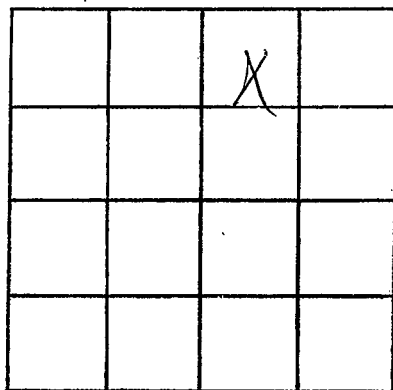

SECTION 12

Please indicate well location X.

ADDITIONAL INFORMATION

If more than one screen, show locations of each on sketch.