

MISSISSIPPI DEPARTMENT OF NATURAL RESOURCES

Bureau of Land and Water Resources

Southport Mall

P.O. Box 10631

Jackson, Mississippi 39209

WATER WELL DRILLERS LOG

Yazoo
E23
3-25-81

march 25 1981 Lenny's Well & Pump firm name Yazoo county well located

LANDOWNER: William Davis

description of formations encountered	from	to
<u>CLAY</u>	<u>0</u>	<u>40</u>
<u>FINE & MED SAND</u>	<u>40</u>	<u>70</u>
<u>CORSE SAND & GRAVEL</u>	<u>70</u>	<u>116</u>

Holly Bluff
(mailing address)

WELL LOCATION:

sec 12 T 12 N R 5 E
7 miles N of Holly Bluff
(distance) (direction) (nearest town)


WELL PURPOSE:

(home, irrigation, municipal, industrial)

WELL COMPLETION DATA:

- (1) diameter (inches) 16"
- (2) total depth (feet) 116'
- (3) static water level (feet) 18 below above top of ground.
- (4) casing Steel 76'
(material) (depth)
(size) If telescope see back.
- (5) screen 40' 76'
(length) (depth to top)
16" Steel
(size) (material)
- (6) pump 60 3000
(HP) (yield gpm)
(type power)
- (7) electric log NO
(yes or no)
(organization running log)
- (8) how well bottom plugged Steel Plate

CODED

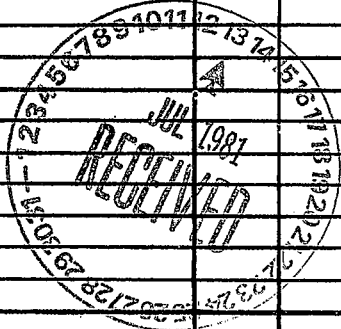


DRILLERS REMARKS:

2

If well telescopes please sketch and show depths.

GROUND LEVEL

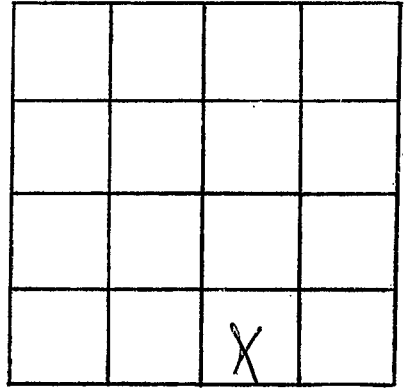

SECTION 12

Please indicate well location X.

ADDITIONAL INFORMATION

If more than one screen,
show locations of each on sketch.