

MISSISSIPPI DEPARTMENT OF NATURAL RESOURCES

Bureau of Land and Water Resources

Southport Mall

P.O. Box 10631

Jackson, Mississippi 39209

WATER WELL DRILLERS LOG

CODED

YAZOO
E25

June 27, 19 84 Larry's well & pump Yazoo
 date well completed firm name county well located

LANDOWNER: John Whisen
Yazoo City, Ms
 (mailing address)
 sec. 1 T. 120 R. 40
S E
5 miles S of Lowndes
 (distance) (direction) (nearest town)

description of formations encountered	from	to
<u>clay</u>	<u>0</u>	<u>40</u>
<u>F.F. Sand</u>	<u>40</u>	<u>70</u>
<u>Coarse sand</u>	<u>70</u>	<u>120</u>

WELL LOCATION:
 (home, irrigation, municipal, industrial)

WELL COMPLETION DATA:

- (1) diameter (inches) 8"
- (2) total depth (feet) 120'
- (3) static water level (feet) 22 ^{below} _{above} top of ground.
- (4) casing PVC, 80'
 (material) (depth)
 (size) if telescope see back.
- (5) screen 40', 80'
 (length) (depth to top)
8", PVC
 (size) (material)
- (6) pump 10, 700
 (HP) (yield gpm)
E
 (type power)
- (7) electric log No
 (yes or no)
 (organization running log)
- (8) how well bottom plugged PVC
cap

CODED


DEPT. OF NATURAL RESOURCES
 BUREAU OF LAND & WATER RESOURCES

OCT 31 1984
 RECEIVED

DRILLERS REMARKS:

If well telescopes please
sketch and show depths.

GROUND LEVEL

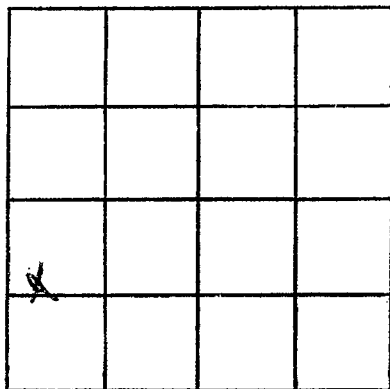

SECTION 1

Please indicate well location X.

ADDITIONAL INFORMATION

If more than one screen,
show locations of each on sketch.