

Gw 3806

E 27 Elog # 304

YAZOO

06-00-84

MISSISSIPPI  
 BOARD OF WATER COMMISSIONERS  
 416 North State Street  
 Jackson, Mississippi 39201

COBED

WATER WELL DRILLERS LOG

June

1984 ROBERT E. RATLIFF CO., INC.

Yazoo

date well completed

firm name

county well located

LANDOWNER:

Lake City W. A.  
 Route 4 Box 259  
 Yazoo City, Ms. 39194  
 (mailing address)

description of formations encountered

from to

Sand & gravel	0	160
Clay	160	320
Sand	320	440
Clay	440	480
Sand	480	570
Clay	570	960
Sand	960	980
Clay	980	1060
Sand	1060	1080
Clay	1080	1160
Sand	1160	1220
Clay	1220	1230
Sand	1230	1300

WELL LOCATION:

sec. 34 T. 4 N. R. 5 W.  
 12 E

(distance) miles (direction) of (nearest town)

WELL PURPOSE:

(home, irrigation, municipal, industrial)

WELL COMPLETION DATA:

- (1) diameter (inches) 10"
- (2) total depth (feet) 1300'
- (3) static water level (feet) 23' below top of ground.
- (4) casing Steel, 1242' (material) (depth)  
 10" (size) If telescope see back.
- (5) screen 50' (length), 1242' (depth to top)  
 6" (size), stainless steel (material)
- (6) pump 25 (HP), (yield gpm)  
 electric (type power)
- (7) electric log (yes or no)  
 M & G (organization running log)
- (8) how well bottom plugged B.P.V.

DRILLERS REMARKS:


DEPT. OF NATURAL RESOURCES  
 BUREAU OF LAND & WATER RESOURCES

JUN 28 1984  
 RECEIVED

①

If well telescopes please sketch and show depths.

GROUND LEVEL

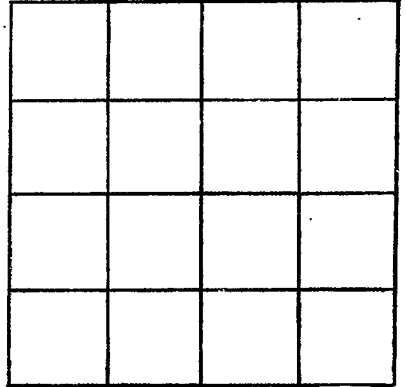

SECTION \_\_\_\_\_

Please indicate well location X.

ADDITIONAL INFORMATION

If more than one screen, show locations of each on sketch.