

MISSISSIPPI DEPARTMENT OF NATURAL RESOURCES

Bureau of Land and Water Resources

Southport Mall

P.O. Box 10631

Jackson, Mississippi 39209

WATER WELL DRILLERS LOG

Y4200  
E 28

CODED

10-15 19 85 Lamp's well's pump Y4200  
date well completed firm name county well located

LANDOWNER: Tommy Woodard	description of formations encountered	from	to
Holly Bluff ms. (mailing address)	Sand	880	1005
<p>WELL LOCATION:</p> <p>sec. 18 T. 12<sup>N</sup> S. R. 4 E. W. 10</p> <p>6 miles NE of Holly Bluff (distance) (direction) (nearest town)</p>			
<p>WELL PURPOSE: Fish Hatchery (home, irrigation, municipal, industrial)</p>			
<p>WELL COMPLETION DATA:</p>			
<p>(1) diameter (inches) 8" x 4"</p>			
<p>(2) total depth (feet) 105</p>			
<p>(3) static water level (feet) 22' below above top of ground.</p>			
<p>(4) casing Steel (material) (depth) 8x4" If telescope see back. (size)</p>			
<p>(5) screen 40' 9'5" to 105' (length) (depth to top)</p>			
<p>2" Stainless (size) (material)</p>			
<p>(6) pump 20 (HP) 200 (yield gpm)</p>			
<p>Electric (type power)</p>			
<p>(7) electric log no (yes or no)</p>			
<p>(organization running log)</p>			
<p>(8) how well bottom plugged Shut</p>			
<p>DRILLERS REMARKS:</p>			

CODED

RECEIVED

MAY 11 1987

Department of Natural Resources  
Bureau of Land & Water Resources


If well telescopes please sketch and show depths.

GROUND LEVEL

220' 8" Steel

1775' 4" Steel

40' 4" Stainless  
Screen

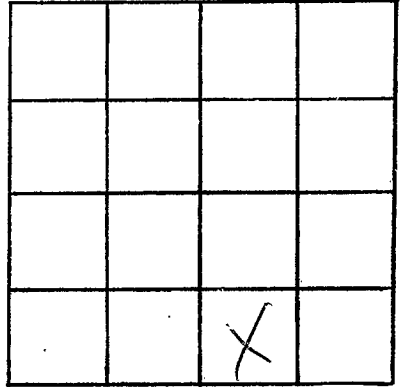

SECTION 18

Please indicate well location X.

ADDITIONAL INFORMATION

If more than one screen,  
show locations of each on sketch.