

YA200

MISSISSIPPI BOARD OF WATER CONTROL

32-51-32 90-43-30

E-300

E 2000

WATER WELL DRILLERS LOG

7-14-60

Date: July 14, 1960, Driller: J. H. Baines water well County: Yazoo (Name)

(1) Owner of Land: FRED L. BONWIE (Name) HOLLYBLUFF MISS. (Address)

Description & Color of Materials Sand, Clay, Red Clay, Shell, etc.	Thick- ness Feet	Depth Feet
BLUE CLAY	40	40
WATER SAND	94	54


(2) Location: SE 1/4, NE 1/4, Sec. 29 T12R5W 2 miles NORTH of HOLLYBLUFF (distance) (direction) (Nearest Town)

(3) Topography: FLAT (Hilly) (Flat) (Level)

(4) Purpose of Well: FARM USE (Domestic Irrigation Municipal, Industrial, Other)

Information upon completion of well:

- (1) Diameter 2" inches.
- (2) Total Depth 94 feet.
- (3) Water Level 21 feet below top of ground.
- (4) Cased to 90, Size 2"
- (5) Screen: Size 60 Hrs., Length 4 feet.
- (6) Were any formations sealed against pollution? yes, no.

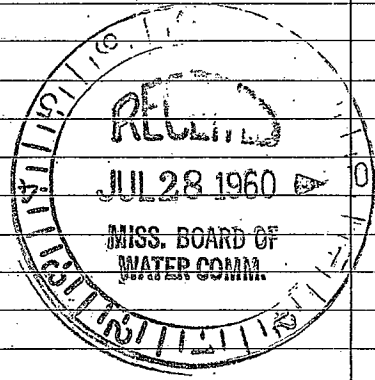

If YES depth of formation Why Drillers Remarks:

(Use Back Side)

Well No.

1944

1945

1946

1947

1948

1949

1950

1951

1952

1953

1954

1955