

YA200  
E 300

WATER WELL DRILLERS LOG

5 E 10

Date: July 29, 1961, Driller: J. K. Barnes County Yazoo  
7-28-61 (Name)

(1) Owner of Land: William Neal  
(Name)  
Holly Bluff Miss  
(Address)

(2) Location: S.W. 1/4, S.W. 1/4, Sec. 13 T12 R5  
1/2 miles west of BAYLAND  
(distance) (direction) (Nearest Town)

(3) Topography: FLAT  
(Hilly) (Flat) (Level)

(4) Purpose of Well: FARM  
(Domestic Irrigation  
Municipal, Industrial, Other)

Description & Color of Materials Sand, Clay, Red Clay, Shell, etc.	Thick- ness Feet	Depth Feet
<u>Gray Clay</u>	<u>210</u>	<u>240</u>
<u>Shd of</u>	<u>110</u>	<u>150</u>
<u>Blue Clay</u>	<u>200</u>	<u>350</u>
<u>Dark Shown</u>	<u>50</u>	<u>400</u>
<u>Shell Gray</u>	<u>100</u>	<u>500</u>
<u>Water Sand</u>	<u>110</u>	<u>610</u>
<u>Shell Dark</u>	<u>200</u>	<u>810</u>
<u>Rock</u>	<u>1</u>	<u>811</u>
<u>Shell dark Gray</u>	<u>110</u>	<u>921</u>
<u>Water Sand</u>	<u>70</u>	<u>991</u>
<u>Shell dark Blue</u>		
<u>Gray</u>	<u>60</u>	<u>1051</u>
<u>Water Sand</u>	<u>99</u>	<u>1150</u>

Information upon completion of well:

(1) Diameter 4" x 2" inches.

(2) Total Depth 1150 feet.

(3) Water Level 3 feet above feet below top of ground.

(4) Cased to 16 1/2" <sup>9"</sup> 984 Size 4" and 2" 1150


(5) Screen: Size 800.6, Length 30

(6) Were any formations sealed against pollution?  
no yes, no no.

If YES depth of formation \_\_\_\_\_

Why \_\_\_\_\_

Drillers Remarks: \_\_\_\_\_

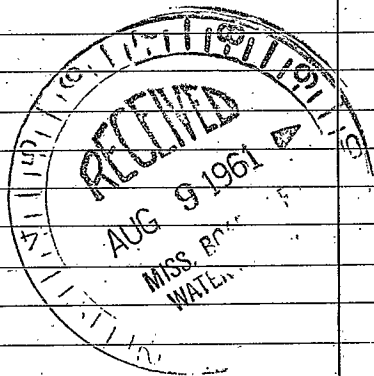

(Use Back Side)

Well No.

