

YA200

F
8-63

MISSISSIPPI BOARD OF WATER COMMISSIONERS

WATER WELL DRILLERS LOG

Date: Aug, 1963, Driller: David Benny County Yazoo
7204 (Name)

(1) Owner of Land: Eldorado Plantation
(Name)
Yazoo City, Miss
(Address) 82 W 11
14 15 17 23 1/2 R 3W

(2) Location: 1/4, 1/4, Sec 14 15 17 23 1/2 R 3W
6 miles NW of Yazoo
(distance) (direction) (Nearest Town)

(3) Topography: Flat
(Hilly) (Flat) (Level)

(4) Purpose of Well: Domestic
(Domestic Irrigation
Municipal, Industrial, Other)

Description & Color of Materials Sand, Clay, Red Clay, Shell, etc.	Thick- ness Feet	Depth Feet
<u>clay</u>	<u>20</u>	<u>20</u>
<u>sandy clay</u>	<u>5</u>	<u>25</u>
<u>sand</u>	<u>15</u>	<u>40</u>
<u>sand</u>	<u>20</u>	<u>60</u>
<u>sand</u>	<u>16</u>	<u>76</u>
<u>gravel</u>	<u>4</u>	<u>80</u>
<u>gravel</u>	<u>10</u>	<u>90</u>

Information upon completion of well:

(1) Diameter 2 inches.

(2) Total Depth 90 feet.

(3) Water Level 26' feet below top of ground.


(4) Cased to 90, Size 2"

(5) Screen: Size 5, Length 2

(6) Were any formations sealed against pollution?
_____ yes, _____ no.

If YES depth of formation _____
Why _____

Drillers Remarks: _____

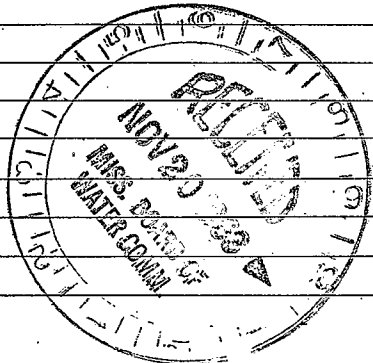

(Use Back Side)

Well No.

