

YAZOO
 F18
 6-68
 Miss Des Loc.

MISSISSIPPI
 BOARD OF WATER COMMISSIONERS
 416 North State Street
 Jackson, Mississippi 39201

WATER WELL DRILLERS LOG

6-22 1968 Sud Russell Yazoo
 date well completed firm name county well located

LANDOWNER: Baird
 Enterprises

Yazoo City, Miss-
 (mailing address)


WELL LOCATION:
 sec 22 T 12 N R 3 E
 4 miles West of Yazoo
 (distance) (direction) (nearest town)

WELL PURPOSE: Stock
 (home, irrigation, municipal, industrial)

WELL COMPLETION DATA:

- (1) diameter (inches) 4 x 2
- (2) total depth (feet) 1160
- (3) static water level (feet) 10 below top of ground.
- (4) casing Pipe, 168 (material), (depth)
 4 (size) if telescope see back.
- (5) screen 30, 1130 (length), (depth to top)
 2, Stainless (size), (material)
- (6) pump (HP) (yield gpm)
 (type power)
- (7) electric log yes (yes or no)
 State (organization running log)
- (8) how well bottom plugged


description of formations encountered	depth	
	from	to
Sand - gravel	0	140
Sand	140	280
Shale	280	370
Sand	370	430
Silty shale	430	760
Sand	760	800
Shale	800	860
Sand	860	900
Silty shale	900	1020
Shale	1020	1120
Sand	1120	1160

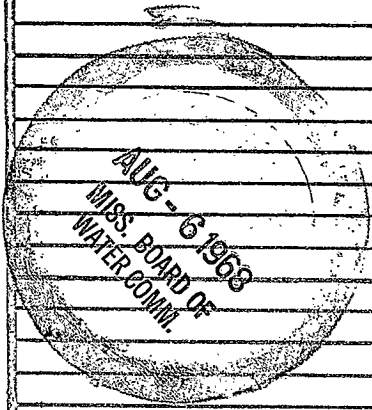

DRILLERS REMARKS:

If well telescopes please sketch and show depths.

GROUND LEVEL

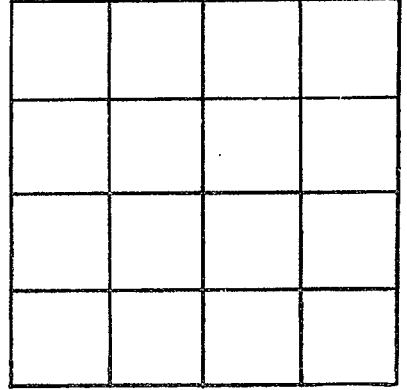

SECTION _____

Please indicate well location X.

ADDITIONAL INFORMATION

If more than one screen, show locations of each on sketch.