

Yazoo Co  
 F 21  
 3-25-70

F 21

MISSISSIPPI  
 BOARD OF WATER COMMISSIONERS  
 416 North State Street  
 Jackson, Mississippi 39201

WATER WELL DRILLERS LOG

**CODED**

DYER WELL & IRRIGATION SERVICE

county well located

3-25-70  
 date well completed

firm name

LANDOWNER:  
 T.R. Coleman  
 YAZOO City, Miss.  
 (mailing address)

description of formations encountered	from	to
Clay	0	20
SAND	20	60
Clay + shale	60	180
SAND + shale	180	750
SAND	750	810
SHALE	810	880
SAND	880	965
SHALE	965	1080
SAND	1080	1110
SHALE	1110	1140

WELL LOCATION:  
 sec. 35 T. 12 N. R. 3 E.  
3 miles SW of YAZOO City  
 (distance) (direction) (nearest town)

WELL PURPOSE: IND.  
 (home, irrigation, municipal, industrial)

WELL COMPLETION DATA:

(1) diameter (inches) 4" X 3"

(2) total depth (feet) 955

(3) static water level (feet) 15 below above top of ground.

(4) casing Steel, 925  
 (material) (depth)  
4 X 3 If telescope see back.  
 (size)

(5) screen 30, 925  
 (length) (depth to top)  
3", Stainless Steel  
 (size) (material)

(6) pump 5, 80  
 (HP) (yield gpm)  
Elec.  
 (type power)

(7) electric log yes  
 (yes or no)  
USGS  
 (organization running log)

**CODED**

MAR 27 1970

MISS. BD. OF  
 WATER COMM.

(8) how well bottom plugged BACK PRESSURE VALVE

DRILLERS REMARKS:


If well telescopes please sketch and show depths.

GROUND LEVEL

168' - 4" CASING →

757' - 3" CASING →

30' - 3" SCREEN →

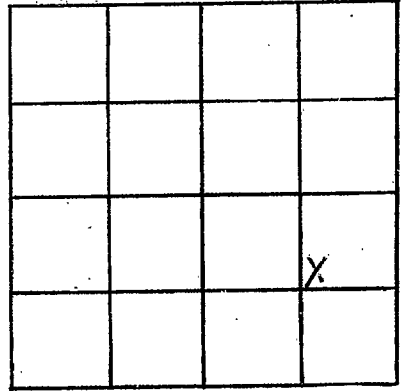

SECTION 1

Please indicate well location X.

ADDITIONAL INFORMATION

If more than one screen, show locations of each on sketch.