

E LOG #223

MISSISSIPPI  
BOARD OF WATER COMMISSIONERS  
416 North State Street  
Jackson, Mississippi 39201

**CODED**

WATER WELL DRILLERS LOG

YA200  
F23  
5-12-71

May 13 1971 McConnell Drilling YA200  
date well completed firm name county well located

LANDOWNER: L. E. Holman

description of formations encountered

from to

Wolf Lake.

Top Soil

0 54

Sand

54 122

(mailing address)

Clay

122 460

WELL LOCATION:

sandy clay & big

460 514

sec. 7 T. 12 N R. 3 E

Sand

514 588

8 miles N.W. of YA200  
(distance) (direction) (nearest town)

big white

588 594

Sand

594 636

WELL PURPOSE: home  
(home, irrigation, municipal, industrial)

WELL COMPLETION DATA:

(1) diameter (inches) 4 X 2'  
(2) total depth (feet) 627'  
(3) static water level (feet) 10 below above top of ground.

**CODED**

(4) casing Steel, 607,  
(material) (depth)  
4 X 2 if telescope see back.  
(size)

(5) screen 20', 6.07  
(length) (depth to top)

2", 5.5.  
(size) (material)

(6) pump 1/2 10  
(HP) (yield gpm)

elect.  
(type power)

(7) electric log Yes  
(yes or no)

MG 3  
(organization running log)

(8) how well bottom plugged.  
Back Wash Valve

RECEIVED  
MAY 18 1971

DRILLERS REMARKS:  
Drilled to 1119'

MISS. BD. OF  
WATER COMM.

If well telescopes please sketch and show depths.

GROUND LEVEL


145' 4"

4x2 Suedge

462' 3"

20' screen

If more than one screen, show locations of each on sketch.

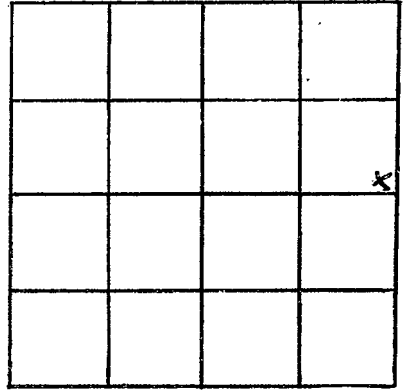

SECTION 7

Please indicate well location X.

ADDITIONAL INFORMATION

Tried to make well @ 980 to 1000'  
Sand was very fine & would not prod.