

**MISSISSIPPI
BOARD OF WATER COMMISSIONERS**
416 North State Street
Jackson, Mississippi 39201

*Return for location
Jan 9-72*

WATER WELL DRILLERS LOG

Jefcoat Drilling Co.

Yazoo

YAZOO
F 26
4-15-72

4/15/72

date well completed

firm name

county well located

LANDOWNER: Jessie Davis

RFD Vaughn Miss.

(mailing address)

**description of formations
encountered**

from

to

Clay and Topsoil
22 sand

0 22

Clay
sand fine

22 28
61 113

WELL LOCATION:

sec. 21 T. 12 N. R. 3 E.
2 miles S / W of Pickens
(distance) (direction) (nearest town)

WELL PURPOSE: Home
(home, irrigation, municipal, industrial)

WELL COMPLETION DATA:


- (1) diameter (inches) 2
- (2) total depth (feet) 113
- (3) static water level (feet) 51 below above top of ground.
- (4) casing galv., 106,
(material) (depth)
2" if telescope see back.
(size)
- (5) screen 6 ft, 106
(length) (depth to top)
2", Galv.
(size) (material)
- (6) pump 1/2 hp 3 gal
(HP) (yield gpm)
Ac
(type power)
- (7) electric log No
(yes or no)
(organization running log)
- (8) how well bottom plugged 1/8 rod

Stamp: MISS. NO. 1317

DRILLERS REMARKS:

If well telescopes please sketch and show depths.

GROUND LEVEL

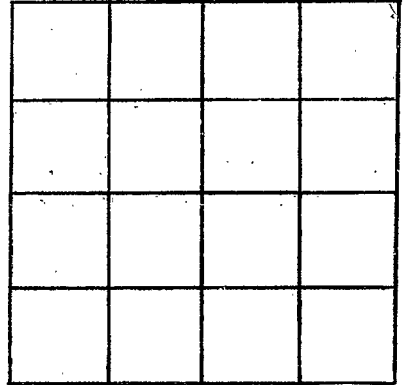

SECTION _____

Please indicate well location X.

ADDITIONAL INFORMATION

If more than one screen, show locations of each on sketch.