

YA200
F29
5-10-74

MISSISSIPPI
 BOARD OF WATER COMMISSIONERS
 416 North State Street
 Jackson, Mississippi 39201

INDEXED

WATER WELL DRILLERS LOG

MAY 10 1974 E. M. "Bud" CREISWELL YA200
 date well completed firm name county well located

LANDOWNER:
W. O. Moore
CARY, Miss.
 (mailing address)

description of formations encountered	from	to
Clay	0	30
Sand-gravel	30	130
Shale	130	320
Argill. shale	320	460
Sand	460	560

WELL LOCATION:
 sec. 17 T. 12 N. R. 3 E.
7 miles W of YA200
 (distance) (direction) (nearest town)

WELL PURPOSE: Farm
 (home, irrigation, municipal, industrial)

- WELL COMPLETION DATA:
- diameter (inches) 4
 - total depth (feet) 560
 - static water level (feet) 8 below surface top of ground.
 - casing steel 520
(material) (depth)
4 if telescope see back.
(size)
 - screen 40 520
(length) (depth to top)
2 Stainless
(size) (material)
 - pump 1 1/2 30
(HP) (yield gpm)
0
(type power)
 - electric log No
(yes or no)
0
(organization running log)

CODED


(8) how well bottom plugged
plug

DRILLERS REMARKS:

MISSISSIPPI
 BOARD OF WATER COMMISSIONERS
 MAY 22 1974

If well telescopes please
sketch and show depths.

GROUND LEVEL

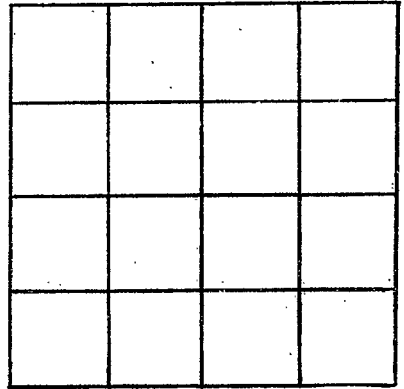

SECTION _____

Please indicate well location X.

ADDITIONAL INFORMATION

If more than one screen,
show locations of each on sketch.