

YA200

F30

10/4/77

MISSISSIPPI
BOARD OF WATER COMMISSIONERS
416 North State Street
Jackson, Mississippi 39201

WATER WELL DRILLERS LOG

CODED

October 4 1977 Bruce Berryman -

YA200

date well completed

Greenwood, MS
firm name

county well located

LANDOWNER: Allen Clinkscales

R.R. 1. Box 142A,

Hollandale. MS 38748

(mailing address)

WELL LOCATION:

sec. 17 T 12 N

R 3 W

6 miles NW of Yazoo City
(distance) (direction) (nearest town)WELL PURPOSE: Home
(home, irrigation, municipal, industrial)

WELL COMPLETION DATA:

- (1) diameter (inches) 4" x 2"
- (2) total depth (feet) 587'
- (3) static water level (feet) 16' below
top of ground. observation
- (4) casing 2" blk. galv. -- 126'
galv. -- 441'
(material) (depth)

If telescope see back.
(size)

- (5) screen 20' 567'
(length) (depth to top)
1/4" O.D. stainless steel
(size) (material)
- (6) pump 1 1/2 50
(HP) (yield gpm)
- Electric
(type power)

- (7) electric log No
(yes or no)

(organization running log)

- (8) how well bottom plugged B.P.V.

DRILLERS REMARKS:


RECEIVED

APR - 5 1978

MISS. BD. OF WATER CONTROL

If well telescopes please sketch and show depths.

GROUND LEVEL

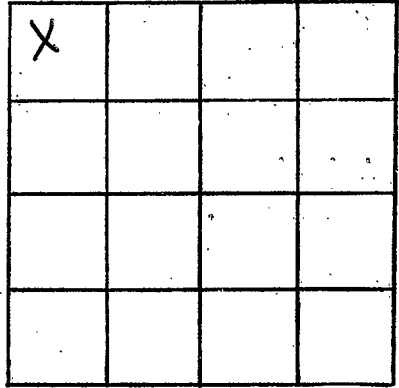

SECTION 17

Please indicate well location X.

ADDITIONAL INFORMATION

Lined area for additional information.

If more than one screen, show locations of each on sketch.