

YAZOO
F35
1/29/79

MISSISSIPPI
BOARD OF WATER COMMISSIONERS
416 North State Street
Jackson, Mississippi 39201

CODED

WATER WELL DRILLERS LOG

January 29, 1979 Dyer Well Irrigation YAZOO
date well completed firm name county well located

LANDOWNER: BRETT Towing Co.
Ch Allen Clinkscales
Yazoo City Miss.
(mailing address)

description of formations encountered	from	to
Clay	0	50
Fine SAND	50	63
SAND + GRAVEL	63	100
SAND	100	113
Bottom 113'	CODED	

WELL LOCATION:
sec. 22 T. 12 N. R. 3 E
S W
7 miles North of Yazoo City
(distance) (direction) (nearest town)

WELL PURPOSE: Irrigation
(home, irrigation, municipal, industrial)

- WELL COMPLETION DATA:
- (1) diameter (inches) 16"
 - (2) total depth (feet) 113'
 - (3) static water level (feet) 18' below top of ground.
 - (4) casing Steel, 73'
(material) (depth)
16" if telescope see back.
(size)
 - (5) screen 40', 73'
(length) (depth to top)
16", Steel
(size) (material)
 - (6) pump 600, 3,000
(HP) (yield gpm)
Diesel
(type power)
 - (7) electric log No
(yes or no)

(organization running log)
(8) how well bottom plugged Plate

DRILLERS REMARKS:

Miss. Board of Water Comm.


MAR 11 1979

RECEIVED



If well telescopes please sketch and show depths.

GROUND LEVEL

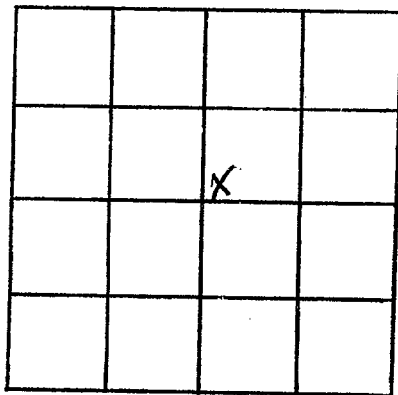

SECTION 22

Please indicate well location X.

ADDITIONAL INFORMATION

If more than one screen, show locations of each on sketch.