

MISSISSIPPI DEPARTMENT OF NATURAL RESOURCES
Bureau of Land and Water Resources
 Southport Mall
 P.O. Box 10631
 Jackson, Mississippi 39209
WATER WELL DRILLERS LOG

YAZOO
F38
9-17-80

CODED

09/17 1980 Larry's well & Pump Yazoo
 date well completed firm name county well located

LANDOWNER: Pat Winston
Yazoo City, MS
 (mailing address)

description of formations encountered	from	to
<u>clay</u>	<u>0</u>	<u>10</u>
<u>fine sand</u>	<u>10</u>	<u>20</u>
<u>med. coarse sand</u>	<u>70</u>	<u>80</u>
<u>coarse sand gravel</u>	<u>80</u>	<u>110</u>

WELL LOCATION:
 sec. 35 T. 12 N. R. 3 E.
5 miles NW of Yazoo City
 (distance) (direction) (nearest town)

WELL PURPOSE: Fish Pond
 (home, irrigation, municipal, industrial)

- WELL COMPLETION DATA:
- (1) diameter (inches) 16"
 - (2) total depth (feet) 110'
 - (3) static water level (feet) 12 below above top of ground.
 - (4) casing Steel, 70'
 (material) (depth)
 _____ if telescope see back.
 (size)
 - (5) screen 40', 70'
 (length) (depth to top)
16", steel
 (size) (material)
 - (6) pump 600 2500
 (HP) (yield gpm)
Electric
 (type power)
 - (7) electric log No
 (yes or no)

 (organization running log)
 - (8) how well bottom plugged Steel
plate

CODED


DEPT. OF NATURAL RESOURCES
 BUREAU OF LAND & WATER RESOURCES

MAY 18 1981
RECEIVED

DRILLERS REMARKS:

If well telescopes please sketch and show depths.

GROUND LEVEL

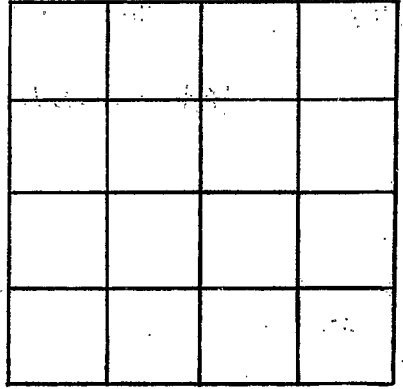

SECTION 35

Please indicate well location X.

ADDITIONAL INFORMATION

If more than one screen, show locations of each on sketch.