

MISSISSIPPI DEPARTMENT OF NATURAL RESOURCES

Bureau of Land and Water Resources

Southport Mall

P.O. Box 10631

Jackson, Mississippi 39209

WATER WELL DRILLERS LOG

YAZOO
F-41
6-4-81

date well completed 6-4-81 1981 firm name Dyer Well & Drilling county well located Yazoo

LANDOWNER: <u>T.L. Coleman</u>	description of formations encountered	from	to
<u>Yazoo City, MS</u> (mailing address)	<b>CODED</b> <u>clay</u>	<u>0</u>	<u>10</u>
WELL LOCATION: sec. <u>34</u> T. <u>12</u> N. R. <u>3</u> E. <u>4</u> miles <u>W</u> of <u>Yazoo City</u> (distance) (direction) (nearest town)	<u>Sand</u>	<u>10</u>	<u>73</u>
WELL PURPOSE: (home, irrigation, municipal, industrial)	<u>Sand &amp; gravel</u>	<u>73</u>	<u>90</u>
WELL COMPLETION DATA: (1) diameter (inches) <u>12"</u> (2) total depth (feet) <u>90'</u> (3) static water level (feet) <u>21'</u> below top of ground. (4) casing <u>Steel</u> , <u>90'</u> , (material) (depth), <u>12"</u> if telescope see back. (size) (5) screen <u>40'</u> , <u>50'</u> (length) (depth to top) <u>12"</u> , <u>Steel</u> (size) (material) (6) pump <u>40</u> <u>2000</u> (HP) (yield gpm) <u>electric</u> (type power) (7) electric log _____ (yes or no) _____ (organization running log) (8) how well bottom plugged <u>plate</u>	<b>CODED</b>		
DRILLERS REMARKS:			

DEPT. OF NATURAL RESOURCES  
BUREAU OF LAND & WATER RESOURCES


JUN 15 1981

RECEIVED

④

If well telescopes please sketch and show depths.

GROUND LEVEL

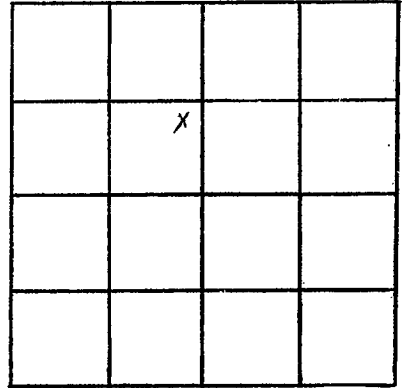

SECTION 34

Please indicate well location X.

ADDITIONAL INFORMATION

If more than one screen,  
show locations of each on sketch.