

MISSISSIPPI DEPARTMENT OF NATURAL RESOURCES

Bureau of Land and Water Resources

Southport Mall

P.O. Box 10631

Jackson, Mississippi 39209

BUTANE GAS CO. OF GREENWOOD

WATER WELL DRILLERS LOG

POST OFFICE BOX 1139
GREENWOOD, MISS. 38930


Yagoo
R42
7-11-81
7-11 1981
date well completed

Yagoo
county well located

LANDOWNER:	description of formations encountered	from	to
<u>Marion Baskin</u>	<u>Fine sand & pack</u>	<u>0</u>	<u>10</u>
<u>Yagoo City Mo.</u>	<u>Fine sand & hard pack</u>	<u>10</u>	<u>40</u>
(mailing address)	<u>Fine sand</u>	<u>40</u>	<u>50</u>
WELL LOCATION:	<u>Fine sand & blue clay</u>	<u>50</u>	<u>75</u>
sec. <u>9</u> T. <u>12</u> N. R. <u>3</u> E. W.	<u>Sand & gravel</u>	<u>75</u>	<u>94</u>
<u>5</u> miles <u>SW</u> of <u>Yagoo Mo.</u>	<u>Gravel</u>	<u>94</u>	<u>110</u>
(distance) (direction) (nearest town)	<u>Sand & gravel</u>	<u>110</u>	<u>119</u>
WELL PURPOSE: <u>irrigation</u>	<u>Clay</u>	<u>119</u>	<u>124</u>
(home, irrigation, municipal, industrial)			
WELL COMPLETION DATA:			
(1) diameter (inches) <u>16"</u>			
(2) total depth (feet) <u>124</u>			
(3) static water level (feet) <u>25</u> (below/above top of ground)			
(4) casing <u>steel</u> , <u>84</u> (material), (depth)			
<u>16"</u> (size) if telescope see back.			
(5) screen <u>40</u> , <u>84</u> (length), (depth to top)			
<u>16"</u> (size), <u>steel</u> (material)			
(6) pump <u>150</u> , <u>1800</u> (HP), (yield gpm)			
<u>Diesel</u> (type power)			
(7) electric log (yes or no)			
(organization running log)			
(8) how well bottom plugged			
<u>Steel plate</u>			
DRILLERS REMARKS:			

CODED

CODED

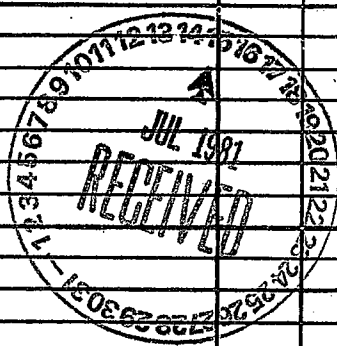

2

If well telescopes please sketch and show depths.

GROUND LEVEL

			X

SECTION 9

Please indicate well location X.

ADDITIONAL INFORMATION

If more than one screen, show locations of each on sketch.