

MISSISSIPPI DEPARTMENT OF NATURAL RESOURCES

Bureau of Land and Water Resources

Southport Mall

P.O. Box 10631

Jackson, Mississippi 39209

WATER WELL DRILLERS LOG

**CODED**

*2 good*  
**F 43**  
 8-27-81

8-27 1981 Water Well & Irrigation Yazoo  
 date well completed firm name county well located

LANDOWNER: The Delta Co. c/o  
Tom Reed  
Belzoni, Miss.  
 (mailing address)

description of formations encountered	from	to
<u>Clay</u>	<u>0</u>	<u>64</u>
<u>Sand + Clay</u>	<u>64</u>	<u>74</u>
<u>Sand + Gravel</u>	<u>74</u>	<u>116</u>

WELL LOCATION:  
 ? sec. 18 T. 24 N. R. 3 E  
8 miles NW of Yazoo City  
 (distance) (direction) (nearest town)

**CODED**

WELL PURPOSE: Irrigation  
 (home, irrigation, municipal, industrial)

WELL COMPLETION DATA:

- (1) diameter (inches) 16"
- (2) total depth (feet) 116'
- (3) static water level (feet) 21' below top of ground.
- (4) casing Steel, 76'  
 (material) (depth)  
16" if telescope see back.  
 (size)
- (5) screen 40', 76'  
 (length) (depth to top)  
16", Mild Steel  
 (size) (material)
- (6) pump 60 3000  
 (HP) (yield gpm)  
Diesel  
 (type power)
- (7) electric log No  
 (yes or no)  
None  
 (organization running log)
- (8) how well bottom plugged Plate

MISSISSIPPI DEPT. OF NATURAL RESOURCES  
 BUREAU OF LAND & WATER RESOURCES

SEP 16 1981


**RECEIVED**

DRILLERS REMARKS:

①

If well telescopes please sketch and show depths.

GROUND LEVEL

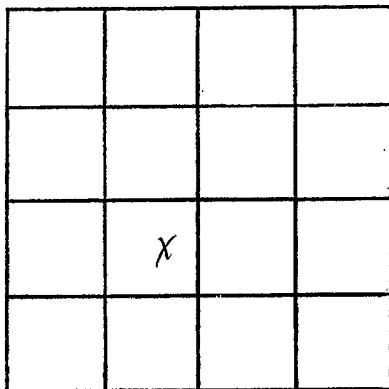

SECTION 18

Please indicate well location X.

ADDITIONAL INFORMATION

If more than one screen, show locations of each on sketch.