

YAZOO
JF 45
6-2-82

MISSISSIPPI DEPARTMENT OF NATURAL RESOURCES
Bureau of Land and Water Resources
Southport Mall
P.O. Box 10631
Jackson, Mississippi 39209
WATER WELL DRILLERS LOG

CODED

June 2 1982 South Delta Yazoo
date well completed firm name county well located

LANDOWNER:
T Stricklin
Yazoo City, MS.
(mailing address)
WELL LOCATION:
sec. 27-T-12(N) R. 3 E. W
5 miles W of Yazoo City
(distance) (direction) (nearest town)

description of formations encountered	from	to
	<u>clay</u>	<u>0</u>
<u>fine sand</u>	<u>20</u>	<u>30</u>
<u>medium sand</u>	<u>30</u>	<u>50</u>
<u>coarse sand</u>	<u>50</u>	<u>93</u>

WELL PURPOSE:
(home, irrigation, municipal, industrial)

CODED

- WELL COMPLETION DATA:
- (1) diameter (inches) 16"
 - (2) total depth (feet) 93'
 - (3) static water level (feet) 21' below top of ground.
 - (4) casing Steel, 53'
(material) (depth)
16" if telescope see back.
(size)
 - (5) screen 40', 53'
(length) (depth to top)
16", steel
(size) (material)
 - (6) pump 80 2000
(HP) (yield gpm)
Diesel
(type power)
 - (7) electric log NO
(yes or no)
(organization running log)
 - (8) how well bottom plugged plate


DRILLERS REMARKS:

DEPT. OF NATURAL RESOURCES
BUREAU OF LAND & WATER RESOURCES

SEP - 8 1982
RECEIVED

If well telescopes please sketch and show depths.

GROUND LEVEL

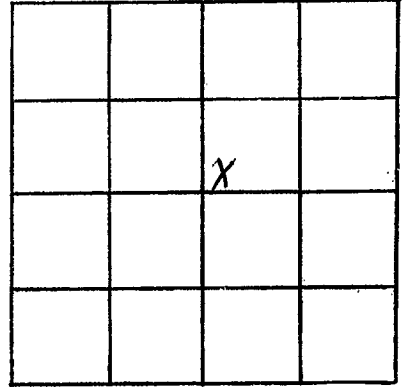

SECTION 27

Please indicate well location X.

ADDITIONAL INFORMATION

If more than one screen, show locations of each on sketch.