

MISSISSIPPI DEPARTMENT OF NATURAL RESOURCES

Bureau of Land and Water Resources

Southport Mall

P.O. Box 10631

Jackson, Mississippi 39209

WATER WELL DRILLERS LOG

CODED

Yazoo
F 47
5-28-82

May 28 19 82 South Delta Yazoo
date well completed firm name county well located

LANDOWNER:	description of formations encountered	from	to
<u>T Stricklin</u>			
<u>Yazoo City, MS</u> (mailing address)	<u>fine sand</u>	<u>10</u>	<u>40</u>
WELL LOCATION:	<u>medium sand</u>	<u>40</u>	<u>80</u>
sec. <u>21</u> T <u>12</u> N R <u>3</u> E S W	<u>coarse sand</u>	<u>80</u>	<u>113</u>
<u>6</u> miles <u>W</u> of <u>Yazoo City</u> (distance) (direction) (nearest town)			
WELL PURPOSE: (home, irrigation, municipal, industrial)			
WELL COMPLETION DATA:			
(1) diameter (inches) <u>16"</u>			
(2) total depth (feet) <u>113'</u>			
(3) static water level (feet) <u>2'</u> below top of ground.			
(4) casing <u>steel</u> , <u>73'</u> (material) (depth)			
<u>16"</u> (size) if telescope see back.			
(5) screen <u>40'</u> , <u>73'</u> (length) (depth to top)			
<u>16"</u> , <u>steel</u> (size) (material)			
(6) pump <u>60</u> , <u>1200</u> (HP) (yield gpm)			
<u>Diesel</u> (type power)			
(7) electric log <u>NO</u> (yes or no)			
(organization running log)			
(8) how well bottom plugged <u>plate</u>			
DRILLERS REMARKS:			


CODED

DEPT. OF NATURAL RESOURCES
BUREAU OF LAND & WATER RESOURCES
SEP-8 1982
RECEIVED

8

If well telescopes please sketch and show depths.

GROUND LEVEL

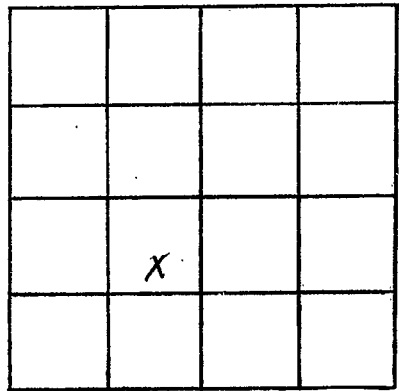

SECTION 21

Please indicate well location X.

ADDITIONAL INFORMATION

Lined area for additional information.

If more than one screen, show locations of each on sketch.