

MISSISSIPPI DEPARTMENT OF NATURAL RESOURCES

Bureau of Land and Water Resources

Southport Mall

P.O. Box 10631

Jackson, Mississippi 39209

WATER WELL DRILLERS LOG

CODED

F50
YAZ00
1/22/84

Jan 22 1984 Larry's well & pump Yazoo County
 (date well completed) (firm name) (county well located)

LANDOWNER: Robert Coker	description of formations encountered	from	to
	clay	0	30
	fine sand	30	50
	coarse sand	50	90

(mailing address)

WELL LOCATION:

sec 2 T 12 N R 3 E
 5 miles NW of Yazoo City
 (distance) (direction) (nearest town)

WELL PURPOSE:

(home, irrigation, municipal, industrial)

WELL COMPLETION DATA:

CODED

- (1) diameter (inches) 16"
- (2) total depth (feet) 98'
- (3) static water level (feet) 15' below top of ground.
- (4) casing Steel (material) (depth) (size) If telescope see back.
- (5) screen (length) (depth to top) 16" Steel (size) (material)
- (6) pump 60 (HP) 1200 (yield gpm) D. (type power)
- (7) electric log No (yes or no) (organization running log)
- (8) how well bottom plugged Steel Plate

DEPT. OF NATURAL RESOURCES
 BUREAU OF LAND & WATER RESOURCES


AUG 20 1984

RECEIVED

DRILLERS REMARKS:

7
If well telescopes please
sketch and show depths.

GROUND LEVEL

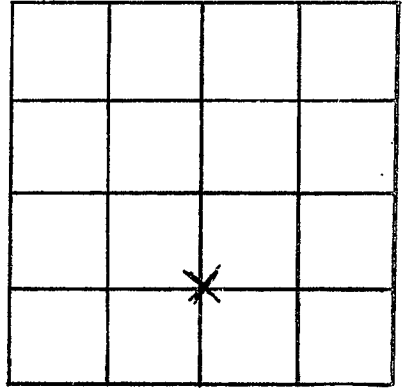

SECTION 2

Please indicate well location X.

ADDITIONAL INFORMATION

If more than one screen,
show locations of each on sketch.