

MISSISSIPPI DEPARTMENT OF NATURAL RESOURCES

Bureau of Land and Water Resources

Southport Mall

P.O. Box 10631

Jackson, Mississippi 39209

WATER WELL DRILLERS LOG

CODED

F51
 YAZOO
 10/3/84


10/3/84 19 Dynac Well firm name Yazoo county well located

LANDOWNER:	description of formations encountered	from	to
<u>Anderson</u> (mailing address)			
WELL LOCATION: sec. <u>9</u> T. <u>12N</u> S. R. <u>3</u> E. <u>W</u> miles _____ of _____ (distance) (direction) (nearest town)	<u>Thin fine sand</u> <u>Sand + gravel</u>	<u>0</u> <u>50</u> <u>68</u>	<u>50</u> <u>68</u> <u>118</u>
WELL PURPOSE: <u>water</u> (home, irrigation, municipal, industrial)			
WELL COMPLETION DATA: (1) diameter (inches) <u>16"</u> (2) total depth (feet) <u>118</u> (3) static water level (feet) <u>11</u> below above top of ground. (4) casing <u>Steel</u> , <u>78</u> , (material) (depth) <u>16"</u> if telescope see back. (size) (5) screen <u>40 ft</u> , <u>78</u> (length) (depth to top) <u>16"</u> , <u>steel</u> (size) (material) (6) pump <u>1.0</u> , <u>3000</u> (HP) (yield gpm) <u>Dies</u> (type power) (7) electric log <u>No</u> (yes or no) <u>No</u> (organization running log) (8) how well bottom plugged _____ <u>STEEL PLATE.</u>			
DRILLERS REMARKS:			

[Handwritten signature]

8
If well telescopes please
sketch and show depths.

GROUND LEVEL

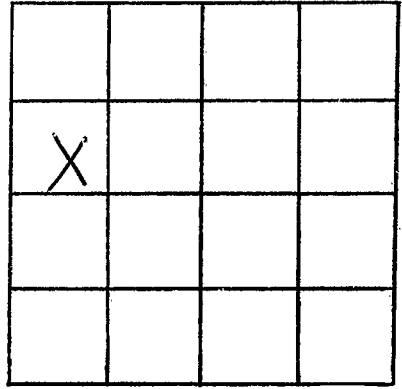

SECTION 9

Please indicate well location X.

ADDITIONAL INFORMATION

If more than one screen,
show locations of each on sketch.