

MISSISSIPPI DEPARTMENT OF NATURAL RESOURCES

Bureau of Land and Water Resources

Southport Mall

P.O. Box 10631

Jackson, Mississippi 39209

WATER WELL DRILLERS LOG

CODED

YAZOO
R53


May 09 1986
date well completed

86 Farming Well Pump
firm name

Yazoo
county well located

LANDOWNER: <u>Don Coleman</u>	description of formations encountered	from	to
		<u>Yazoo City, Miss.</u> (mailing address)	<u>0</u>
WELL LOCATION: sec. <u>35</u> T. <u>12</u> N S. <u>3</u> W <u>2</u> miles <u>W</u> of <u>Yazoo City</u> (distance) (direction) (nearest town)	<u>slaty</u> <u>fine sand</u> <u>coarse sandstone</u>	<u>30</u>	<u>40</u> <u>96</u>
WELL PURPOSE: <u>Fish Pond</u> (home, irrigation, municipal, industrial)			
WELL COMPLETION DATA:			
(1) diameter (inches) <u>12"</u>			
(2) total depth (feet) <u>96'</u>			
(3) static water level (feet) <u>16'</u> <input checked="" type="checkbox"/> below <input type="checkbox"/> above top of ground.			
(4) casing <u>Steel</u> , <u>56'</u> (material) (depth)			
<u> </u> If telescope see back. (size)			
(5) screen <u>40'</u> , <u>56'</u> (length) (depth to top)			
<u>12"</u> , <u>steel</u> (size) (material)			
(6) pump <u>HO</u> , <u>1500</u> (HP) (yield gpm)			
<u>E</u> (type power)			
(7) electric log <u>NO</u> (yes or no)			
<u> </u> (organization running log)			
(8) how well bottom plugged <u>Steel Plate</u>			
DRILLERS REMARKS:			

CODED

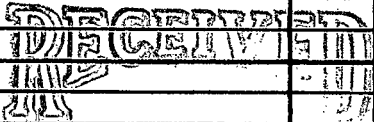


SEP 26 1986

Department of Land and Water Resources

If well telescopes please sketch and show depths.

GROUND LEVEL

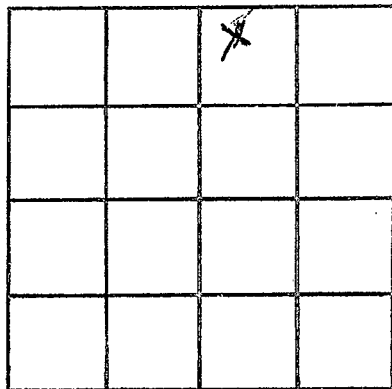

SECTION 25

Please indicate well location X.

ADDITIONAL INFORMATION

If more than one screen, show locations of each on sketch.