

YAZOO
 G-~~53~~
 5-5-71

MISSISSIPPI
 BOARD OF WATER COMMISSIONERS
 416 North State Street
 Jackson, Mississippi 39201

CODED

WATER WELL DRILLERS LOG

May 5 1971 JOAN A. DAVIS YAZOO
 date well completed firm name county well located

LANDOWNER: Ed Warden
 Yazoo City
 (mailing address)
 WELL LOCATION:
 sec. 2 T 12 N R 2 E
 3 miles N of Yazoo City
 (distance) (direction) (nearest town)

description of formations encountered	from	to
Red clay	0	40
Clay & sand	40	65
Bony dent	65	110
White sand	110	122
Blue dent	122	192
Moody's Branch sand	192	220
Blue clay	220	280
Sand breaks fine	280	345
Good sand	345	385

WELL PURPOSE:
 (home, irrigation, municipal, industrial)

WELL COMPLETION DATA:
 (1) diameter (inches) 2
 (2) total depth (feet) 385
 (3) static water level (feet) 110 below above top of ground.
 (4) casing Steel 375 (material) (depth)
 2" (size) if telescope see back.
 (5) screen 10 375 (length) (depth to top)
 2" (size) SS 7 slot (material)
 (6) pump 2 15 (HP) air (yield gpm)
 (type power)
 (7) electric log No (yes or no)
 (organization running log)
 (8) how well bottom plugged Pin

CODED


AUG 5 1971

MISS. Bd. OF
 WATER COM.

DRILLERS REMARKS:

If well telescopes please sketch and show depths.

GROUND LEVEL

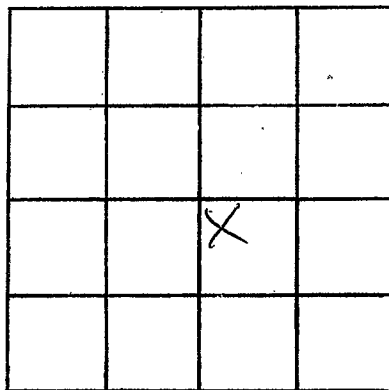

SECTION 2

Please indicate well location X.

ADDITIONAL INFORMATION

If more than one screen,
show locations of each on sketch.