

YA200
G72
7-24-64

MISSISSIPPI BOARD OF WATER COMMISSIONERS

CODED

WATER WELL DRILLERS LOG

Date: 7-24-, 1964, Driller: Layne-Central Co. County Yazoo
(Name)

(1) Owner of Land: Public Service Comm.
(Name)
Yazoo City, Mississippi
(Address)

(2) Location: SW 1/4, NE 1/4, Sec. 32 T12R24
(distance) (direction) (Nearest Town)

(3) Topography: _____
(Hilly) (Flat) (Level)

(4) Purpose of Well: municipal
(Domestic Irrigation
Municipal, Industrial, Other)

Description & Color of Materials Sand, Clay, Red Clay, Shell, etc.	Thick- ness Feet	Depth Feet
clay & gumbo	12	12
blue clay	52	64
fine sand-clay stks	22	86
coarse sand	26	112
sand-clay	15	127
fine sand-lignite	13	140
clay	2	142
fine sand-clay stks	18	160
sand-gravel	22	182
coarse sand & pea gravel	18	200
blue clay	2	202

Information upon completion of well:

(1) Diameter 24 inches.

(2) Total Depth 200 feet.

(3) Water Level 50 feet below top of ground.

(4) Cased to 166', Size 16"


(5) Screen: Size 12", Length 30'

(6) Were any formations sealed against pollution?
 yes, _____ no.

If YES depth of formation 166'
Why required

Drillers Remarks:

CODED

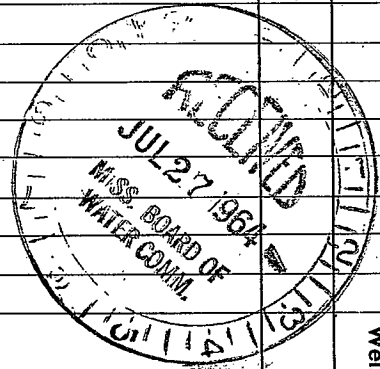

(Use Back Side)

Well No.

1. ...
 2. ...
 3. ...
 4. ...
 5. ...
 6. ...
 7. ...
 8. ...
 9. ...
 10. ...